
1996 REMONUMENTATION PROGRAM LAND CORNER RECORDATION CERTIFICATE

Filing Requirement of Act 74, Mich. P.A. 1970

RECEIVED FOR RECORD D
RECEIVED FOR RECORD LIBER NO. PAGE NO. CP
THE HOLL GILLYCOLL

For corners in GILFORD	TWP.	Located In:	Corner Code #	<i>:</i> I	96 DEC 10 - Ki1 8: 58						
{County}									•		
1. Public Land Survey	-	T_13N_R_07E TR TR	D-13		TUSCOLA COUNTY REGISTER OF BEERS Register of Deeds Stamp & File Number						
 Property Controlling in Section Miscellaneous Property in Sec. 	S	T R T R T R T R		Registe							
4. Lot No, I	Recorded	l Plat			4 В (с D	E	≥ ⊔ 1		L M	
5. Private Claims					6	5	4	3	2	1	
I. JONATHAN M. FIE	ניט	in a field survey on M⊼	V 15 10 0	3 d	7		Q	10	11	12	
I, <u>JONATHAN M. FIELD</u> , in a field survey on <u>MAY 15</u> 19 <u>96</u> do hereby certify that under requirements of P.A. 74, Michigan P.A. of 1970, the corner points mentioned in lines 1 and 2 above were in conformance with regulations and rules therefore as required in the											
current manual of survey in: 9anagement or by a decree	structions of a Court	of the United States Depa of Law and/or that the cor	riment of the Interior, Bureau of ner points mentioned in lines 3, 4 d of Land Surveyors or by a Deci	fLand 7	18	17	16	15	14	13	
Court of Law; established expressed below:	d, re-est	ablished, monumented, r	e-monumented, recovered, fou	ree of a ε ind as γ	19	20	21	22	23	24	
NOTE: Not more than 4	corners	, all in the same town a	and range, may be recorded	10	30	29	28	27	26	25	
on this certificate.				12	31	32	33	34	35	36	
NOTE: THIS CORNE	R IS N	OT COMMON WITH D	-1 T12N-R7E								
1996 ROWE ENG.; POSITION OF	FIELD, CORNE	P.S.#37276; FND R BY SINGLE PROP	d applied in restoring or rees NO EVIDENCE OF CORD ORTION BETWEEN C-13 DD DIVISION LINE TO	NER MONUMI AND E-13	ENT.		STABL POS		_	is	
D-13 SET STANDAY EAST, 41 S57°E, 61. S35°E, 44. NO4°E, 66.	RD REM .22' 3 .01' CI .56' CI .89' N	ON MONUMENT STAM /4" PIPE AT APPA HIS. NOTCH TOP E. HIS. NOTCH TOP W.	es established to perpetuate PED "D 13 T13N R7E" RENT D-1 T12N-R7E END 12" CMP (SET) END 12" CMP (SET) END 12" CMP (SET) EN E. FACE P.POLE (SET)	IN MON. BO	oositio OX	n of th	e corne	M C H	:	ы -	
Signed by first. Surveyor's Michigan Lice	nse No.	7-Liel 37276	Date	5-96 FORM APPROVED B	Y MICHIGA		JONA M. F PROFES SURV No. S72	EYOR	1 m	I. 28, 1971	
		APPRO	VED J.R.C.			ADAPT	ED FOR WO		MEVISED J. SSING MAF		

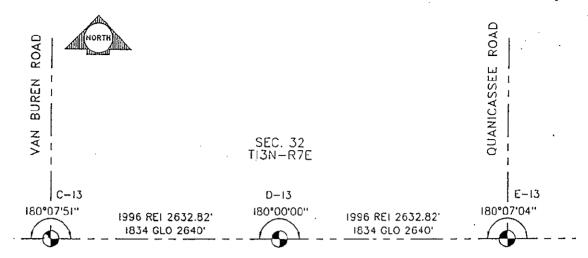

VAN GIESEN ROAD

SEC. 5 TI2N-R7E