

1996 REMONUMENTATION PROGRAM  
 LAND CORNER RECORDATION CERTIFICATE  
 Filing Requirement of Act 74, Mich. P.A. 1970

RECEIVED FOR RECORD  
 LICER NO. \_\_\_\_\_ PAGE NO. 67  
 FILE NO. Gilford

96 DEC 10 AM 8:50

*Jonathan M. Field*  
 TUSCOLA COUNTY  
 REGISTER OF DEEDS

Register of Deeds Stamp & File Number

For corners in GILFORD TWP.

<u>TUSCOLA</u> (County)	Located In:	Corner Code #
1. Public Land Survey	T <u>13N</u> R <u>07E</u>	<u>E-13</u>
	T _____ R _____	_____
	T _____ R _____	_____
	T _____ R _____	_____
2. Property Controlling in Section	S _____ T _____ R _____	_____
	S _____ T _____ R _____	_____
3. Miscellaneous Property in Sec.	S _____ T _____ R _____	_____
	S _____ T _____ R _____	_____

4. Lot No. \_\_\_\_\_, Recorded Plat \_\_\_\_\_  
 5. Private Claims \_\_\_\_\_

	A	B	C	D	E	F	G	H	I	J	K	L	M
1													
2	6		5		4		3		2		1		
3													
4	7		8		9		10		11		12		
5													
6	18		17		16		15		14		13		
7													
8	19		20		21		22		23		24		
9													
10	30		29		28		27		26		25		
11													
12	31		32		33		34		35		36		
13													

I, JONATHAN M. FIELD, in a field survey on MAY 15 19 96, do hereby certify that under requirements of P.A. 74, Michigan P.A. of 1970, the corner points mentioned in lines 1 and 2 above were in conformance with regulations and rules therefore as required in the current manual of survey instructions of the United States Department of the Interior, Bureau of Land Management or by a decree of a Court of Law and/or that the corner points mentioned in lines 3, 4 and 5 above were in conformance with the rules of the Michigan Board of Land Surveyors or by a Decree of a Court of Law; established, re-established, monumented, re-monumented, recovered, found as expressed below:

NOTE: Not more than 4 corners, all in the same town and range, may be recorded on this certificate.

- A. Description of original monument and accessories and/or subsequent restoration:  
 1834 GLO; RISDON, D.S.; SET POST; W OAK 24 N64W 47LKS, W ASH 14 N19E 42LKS  
 1982 BOLDT, P.S.#28405; LCRC PG.38; FND 5/8" PIPE; EAST 24.40' NE COR SEC 5, T12N-R7E, N40E 69.28' NAIL W/ REI TAG IN P/P, N40W 54.40' NAIL W/ REI TAG IN PP, S45E 28.59' NW COR WEST CONC HDWL.  
 1990 ROWE ENG.; BROWN, P.S. 33134; SURVEY L.604, PG.1374; FND 5/8" PIPE; SAME OBJECT AND WITS AS 1982 SURVEY ABOVE EXCEPT S45E 27.59' NW COR. OF W. CONC. HEADWALL


GLO NOTES FOR T12N-R7E INDICATE THAT THIS CORNER IS NOT COMMON WITH E-1 T12N-R7E

- B. Description of corner evidence found and/or method applied in restoring or reestablishing corner:  
 1996 ROWE ENG.; FIELD, P.S.#37276; FND. 5/8" PIPE 2.5' S. OF C/L ASPH. RD. E-W & 4' E. OF EXTENDED C/L OF ASPH. RD. TO N. RECOVERED 3 PREVIOUS WITNESSES WHICH INDICATE THAT FND. PIPE IS IN SAME POSITION AS 1982 LCRC CITED ABOVE

ACCEPTED FND. PIPE AS BEST EVIDENCE OF ORIGINAL CORNER POSITION

- C. Description of monument for corner and accessories established to perpetuate locating the position of the corner:  
 E-13 REPLACED PIPE W/ STANDARD REMON MONUMENT STAMPED "E 13 T13N R7E" IN MON BOX  
 N20°W, 54.37' FND. NAIL W/CAP #20709 IN SW FACE P.POLE  
 N42°E, 69.18' FND. NAIL W/TAG #11192 IN NW FACE P.POLE  
 EAST, 24.37' FND. 3/4" PIPE AT APPARENT E-1, T12N-R7E  
 S36°E, 27.66' NW CORNER OF W. CONC. BRIDGE WALL

Signed by Jonathan M. Field Date 11-6-96  
 Surveyor's Michigan License No. 37276

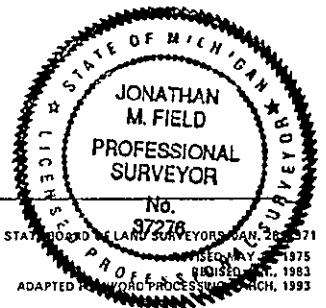

APPROVED  
11-4-96

FORM APPROVED BY MICHIGAN STATE BOARD OF LAND SURVEYORS JAN. 26, 1971  
 REVISIONS: MAY 1975  
 REVISIONS: FEB. 1983  
 ADAPTED FROM BOARD PROCESSING FORM, MICH. 1983

