

1996 REMONUMENTATION PROGRAM  
LAND CORNER RECORDATION CERTIFICATE

Filing Requirement of Act 74, Mich. P.A. 1970

RECEIVED FOR RECORD  
BOOK NO. \_\_\_\_\_ PAGE NO. 66  
TUSCOLA

96 DEC 10 AM 8:58

*Jonathan M. Field*  
TUSCOLA COUNTY  
REGISTER OF DEEDS

Register of Deeds Stamp & File Number

For corners in GILFORD TWP.

TUSCOLA Located in: \_\_\_\_\_ Corner Code # \_\_\_\_\_  
(County)

1. Public Land Survey T 13N R 07E \_\_\_\_\_ F-13 \_\_\_\_\_  
T \_\_\_\_\_ R \_\_\_\_\_ \_\_\_\_\_  
T \_\_\_\_\_ R \_\_\_\_\_ \_\_\_\_\_  
T \_\_\_\_\_ R \_\_\_\_\_ \_\_\_\_\_

2. Property Controlling S \_\_\_\_\_ T \_\_\_\_\_ R \_\_\_\_\_  
in Section S \_\_\_\_\_ T \_\_\_\_\_ R \_\_\_\_\_  
3. Miscellaneous S \_\_\_\_\_ T \_\_\_\_\_ R \_\_\_\_\_  
Property in Sec. S \_\_\_\_\_ T \_\_\_\_\_ R \_\_\_\_\_

4. Lot No. \_\_\_\_\_, Recorded Plat \_\_\_\_\_  
5. Private Claims \_\_\_\_\_

I, JONATHAN M. FIELD, in a field survey on MAY 15 19 96  
do hereby certify that under requirements of P.A. 74, Michigan P.A. of 1970, the corner points mentioned  
in lines 1 and 2 above were in conformance with regulations and rules therefore as required in the  
current manual of survey instructions of the United States Department of the Interior, Bureau of Land  
Management or by a decree of a Court of Law and/or that the corner points mentioned in lines 3, 4 and 5  
above were in conformance with the rules of the Michigan Board of Land Surveyors or by a Decree of a  
Court of Law; established, re-established, monumented, re-monumented, recovered, found as  
expressed below:

NOTE: Not more than 4 corners, all in the same town and range, may be recorded  
on this certificate.

	A	B	C	D	E	F	G	H	I	J	K	L	M
1													
2	6	5	4	3	2	1							
3													
4	7	8	9	10	11	12							
5													
6	18	17	16	15	14	13							
7													
8	19	20	21	22	23	24							
9													
10	30	29	28	27	26	25							
11													
12	31	32	33	34	35	36							
13													

A. Description of original monument and accessories and/or subsequent restoration:  
1834 GLO; RISDON, D.S.; SET POST; BIRCH 14 N59E 71LKS, ELM 8 N61W 38LKS


NOTE: THIS CORNER IS NOT COMMON WITH F-1 T12N-R7E

B. Description of corner evidence found and/or method applied in restoring or reestablishing corner:  
1996 ROWE ENG.; FIELD, P.S.#37276; FND. NO EVIDENCE OF CORNER MONUMENT. REESTABLISHED  
POSITION FOR CORNER BY SINGLE PROPORTION BETWEEN E-13 AND G-13 T12N-R7E. POSITION THUS  
ESTABLISHED FALLS ON OCCUPIED TREE LINE TO N.

ACCEPTED SINGLE PROPORTION AS BEST EVIDENCE OF ORIGINAL CORNER POSITION

C. Description of monument for corner and accessories established to perpetuate locating the position of the corner:  
F-13 SET STANDARD REMON MONUMENT STAMPED "F 13 T13N R7E" IN MON. BOX  
N81°W, 50.81' SET 1/2" ROD W/CAP #37276  
S52°E, 38.43' NW CORNER CONC HEADWALL  
S79°W, 75.99' SET 1/2" ROD W/CAP #37276  
N11°E, 50.02' SET NAIL W/REMON TAG IN SE FACE 10" MAPLE

Signed by Jonathan M. Field Date 11-6-96  
Surveyor's Michigan License No. 37276

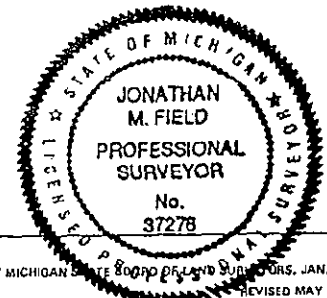

APPROVED  
11-4-96

QUANICASSEE ROAD



BRADFORD ROAD

SEC. 33  
T13N-R7E

E-13

F-13

G-13

180°07'04"

1996 REI 2645.84'  
1834 GLO 2640'

180°00'00"

1996 REI 2645.84'  
1834 GLO 2640'

179°59'14"

VAN GIESEN ROAD

SEC. 4  
T12N-R7E