
1996 REMONUMENTATION PROGRAM LAND CORNER RECORDATION CERTIFICATE

Filing Requirement of Act 74, Mich. P.A. 1970 RECEIVED FOR RECORD LIBER NO. A. P. GENOLO 4 For corners in GILFORD TWP. TUSCOLA Located in: Corner Code # (County) 96 DEC 10 AM 8: 57 1. Public Land Survey T_13N_R_07E H-13 any more R 2. Property Controlling in Section S Register of Deeds Stamp & File Number 3. Miscellaneous T Property in Sec. 4. Lot No. _, Recorded Plat 1 ^A 8 C D E F G H I J K 5. Private Claims _ 2 6 5 Δ 3 2 1 3 , JONATHAN M. FIELD , in a field survey on MAY 15 4 7 8 9 19 _96 10 1-1 12 do hereby certify that under requirements of P.A. 74, Michigan P.A. of 1970, the corner points mentioned in lines 1 and 2 above were in conformance with regulations and rules therefore as required in the current manual of survey instructions of the United States Department of the Interior, Bureau of Land 6 18 17 16 15 14 13 9anagement or by a decree of a Court of Law and/or that the corner points mentioned in lines 3, 4 and 5 7 above were in conformance with the rules of the Michigan Board of Land Surveyors or by a Decree of a Court of Law; established, re-established, monumented, re-monumented, recovered, found as 19 20 8 21 22 23 24 expressed below: 30 29 28 27 26 25 NOTE: Not more than 4 corners, all in the same town and range, may be recorded -11 on this certificate. 12 34 35 36 13 Description of original monument and accessories and/or subsequent restoration: 1834 GLO; RISDON, D.S.; SET POST; ELM 9 N68E 31LKS, TAMARACK 10 N37W 68LKS 1974 ROWE, P.S. 11192; LCRC PG.14; SET 1/2" REROD AS OCCUPIED ON PLOWED LINE TO N. & ON LINE BETWEEN SW & SE SEC. CORNERS; NORTH 27.92' RLS TAG 11192 IN 6" COR POST, NORTH 9.5' C/L PVMT, EAST 25.60 REROD AT N1/4 COR. SEC.3 T12N-R7E 1977 LEACH ENG.; TOMMER, P.S.#22444; SURVEY OF NW 1/4 SEC.3 T12N-R7E L.477, PG.998; H-13 USED AS WITNESS OF WEST 25.60' FROM H-1 Tl2N-R7E NOTE: THIS CORNER IS NOT COMMON WITH H-1, T12N-R7E Description of corner evidence found and/or method applied in restoring or reestablishing corner: 1996 ROWE ENG.; FIELD, P.S.#37276; FND. 1/2" ROD W/CAP #11192 AT S. EDGE OF ASPH. RD. E-W & IN LINE WITH FIELD DIVISION TO N. RECOVERED 2 PREVIOUS WITNESSES WHICH INDICATE THAT FND ROD IS IN SAME POSITION AS 1974 LCRC CITED ABOVE ACCEPTED FND. 1/2" ROD AS BEST EVIDENCE OF ORIGINAL CORNER POSITION Description of monument for corner and accessories established to perpetuate locating the position of the corner: H-13 REPLACED FND. 1/2" ROD W/ STANDARD REMON MONUMENT STAMPED "H 13 T13N R7E" IN MON. BOX EAST, 25.62' FND. 1/2" ROD AT APPARENT H-1 T12N-R7E N47°W, 29.34' SET 1/2" ROD W/CAP #37276 S40°E, 41.75' SET P-K NAIL W/TAG #37276 IN NE FACE FENCE POST N58°E, 42.65' SET 1/2" ROD W/CAP #37276 HICHIO JONATHAN M. FIELD **PROFESSIONAL** SURVEYOR No. 37278 Surveyo(s Michigan License No. 37276 OFESE APPROVED 11-4-46 ADAPTED FOI

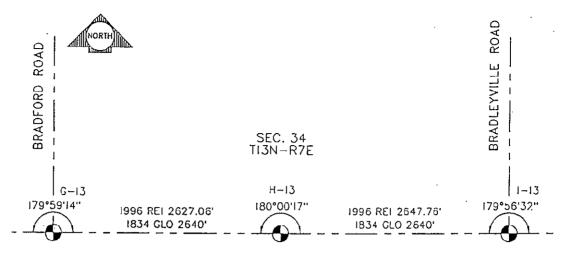

VAN GIESEN ROAD

SEC. 3 TI2N-R7E