

1996 REMONUMENTATION PROGRAM
LAND CORNER RECORDATION CERTIFICATE
Filing Requirement of Act 74, Mich. P.A. 1970

RECEIVED FOR RECORD
NUMBER... PAGE NO. 63
TOWNSHIP Gilford

95 DEC 10 AM 8:56

George M. Field
TUSCOLA COUNTY
REGISTER OF DEEDS

Register of Deeds Stamp & File Number

For corners in GILFORD TWP.
TUSCOLA Located In: Corner Code #
(County)

1. Public Land Survey T 13N R 07E I-13
T _____ R _____
T _____ R _____
T _____ R _____

2. Property Controlling S _____ T _____ R _____
in Section S _____ T _____ R _____

3. Miscellaneous S _____ T _____ R _____
Property in Sec. S _____ T _____ R _____

4. Lot No. _____, Recorded Plat _____
5. Private Claims _____

I, JONATHAN M. FIELD, in a field survey on MAY 15 1996, do hereby certify that under requirements of P.A. 74, Michigan P.A. of 1970, the corner points mentioned in lines 1 and 2 above were in conformance with regulations and rules therefore as required in the current manual of survey instructions of the United States Department of the Interior, Bureau of Land Management or by a decree of a Court of Law and/or that the corner points mentioned in lines 3, 4 and 5 above were in conformance with the rules of the Michigan Board of Land Surveyors or by a Decree of a Court of Law; established, re-established, monumented, re-monumented, recovered, found as expressed below:

NOTE: Not more than 4 corners, all in the same town and range, may be recorded on this certificate.

	A	B	C	D	E	F	G	H	I	J	K	L	M
1													
2	6	5	4	3	2	1							
3													
4	7	8	9	10	11	12							
5													
6	18	17	16	15	14	13							
7													
8	19	20	21	22	23	24							
9													
10	30	29	28	27	26	25							
11													
12	31	32	33	34	35	36							
13													


- A. Description of original monument and accessories and/or subsequent restoration:
 1834 GLO; RISDON, D.S.; SET POST; BEECH 12 N65W 32LKS, BEECH 10 N39E 49LKS
 1903 BRUMLEY, C.S.; EST. 4 LKS E OF COR SEC 2&3 T12N-R7E; SUGAR 4 N34W 74 1/2LKS
 1974 ROWE, P.S.#11192; LCRC PG.18; SET RR SPIKE W/ CHIS "+" ON LINE W/ NW & NE CORNERS OF SEC.3 T12N-R7E; N45W 45.27' NAIL IN T/P, S55W 45.40' NAIL IN P/P, S55E 52.3' NAIL IN P/P
 1974 ROWE ENG.; ROWE, P.S.#11192; SURVEY L.445, PG.763; NO OBJECT STATED, NO WITS GIVEN
 1993 ROWE ENG.; FIELD, P.S.#37276; UNRECORDED SURVEY; FND RR SPIKE W/ CHIS "+"; SAME WITS AS 1974 LCRC ABOVE; ALSO ADDED N25E 73.62' NAIL IN P.POLE, WEST 2.64' 1/4" BAR
 1994 ROWE ENG.; FIELD, P.S.#37276; SURVEY L.663, PG.438; FND RR SPIKE W/ "+"; SAME WITS AS 1993 SURVEY ABOVE

GLO NOTES FOR T12N-R7E INDICATE THAT THIS CORNER IS NOT COMMON WITH I-1, T12N-R7E

- B. Description of corner evidence found and/or method applied in restoring or reestablishing corner.
 1996 ROWE ENG.; FIELD, P.S.#37276; FND. 3/4" PIPE IN MON. BOX 0.5' E. & 1.0' S. OF C/L-C/L ASPH. ROADS N-S-E-W. RECOVERED 3 PREVIOUS WITNESSES WHICH INDICATE THAT FND PIPE IS IN SAME POSITION AS 1974 LCRC CITED ABOVE.

ACCEPTED FND. 3/4" PIPE IN MON. BOX AS BEST EVIDENCE OF ORIGINAL CORNER POSITION

- C. Description of monument for corner and accessories established to perpetuate locating the position of the corner:
 I-13 SET 5/8" ROD.W/ STANDARD REMON CAP STAMPED "I 13 T13N R7E" INSIDE 3/4" PIPE, ENCASED BOTH IN CONC. IN MON. BOX
- WEST 2.64' FND. 1/4"x3" IRON BAR
 S50°W 45.27' FND. NAIL W/FLAG. IN NE FACE P.POLE
 N47°W 45.90' SET P-K NAIL W/TAG #37276 NE FACE P.POLE
 S61°E 52.62' SET P-K NAIL W/TAG #37276 SW FACE P.POLE
 N64°E 40.97' S. EDGE STOP SIGN POST

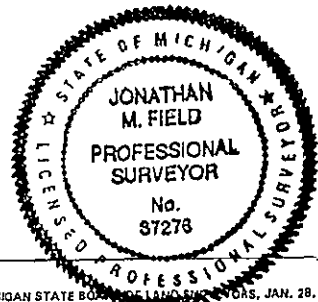

Signed by Jonathan M. Field Date 11-6-96
 Surveyor's Michigan License No. 37276

APPROVED
11-4-96
[Signature]

