

1996 REMONUMENTATION PROGRAM  
LAND CORNER RECORDATION CERTIFICATE

Filing Requirement of Act 74, Mich. P.A. 1970

RECEIVED FOR RECORD  
LIBER NO. \_\_\_\_\_ PAGE NO. 62  
FILE NO. Gifford

95 DEC 10 AM 8:56

*Gregory M. Field*  
TUSCOLA COUNTY  
REC. ST. CLERK

Register of Deeds Stamp & File Number

For corners in GILFORD TWP.  
TUSCOLA  
(County)

Located In: \_\_\_\_\_ Corner Code # \_\_\_\_\_

1. Public Land Survey T 13N R 07E \_\_\_\_\_ J-13 \_\_\_\_\_  
T \_\_\_\_\_ R \_\_\_\_\_  
T \_\_\_\_\_ R \_\_\_\_\_  
T \_\_\_\_\_ R \_\_\_\_\_

2. Property Controlling S \_\_\_\_\_ T \_\_\_\_\_ R \_\_\_\_\_  
in Section S \_\_\_\_\_ T \_\_\_\_\_ R \_\_\_\_\_

3. Miscellaneous S \_\_\_\_\_ T \_\_\_\_\_ R \_\_\_\_\_  
Property in Sec. S \_\_\_\_\_ T \_\_\_\_\_ R \_\_\_\_\_

4. Lot No. \_\_\_\_\_, Recorded Plat \_\_\_\_\_  
5. Private Claims \_\_\_\_\_

I, JONATHAN M. FIELD, in a field survey on MAY 15 19 96, do hereby certify that under requirements of P.A. 74, Michigan P.A. of 1970, the corner points mentioned in lines 1 and 2 above were in conformance with regulations and rules therefore as required in the current manual of survey instructions of the United States Department of the Interior, Bureau of Land Management or by a decree of a Court of Law and/or that the corner points mentioned in lines 3, 4 and 5 above were in conformance with the rules of the Michigan Board of Land Surveyors or by a Decree of a Court of Law; established, re-established, monumented, re-monumented, recovered, found as expressed below:

NOTE: Not more than 4 corners, all in the same town and range, may be recorded on this certificate.

	A	B	C	D	E	F	G	H	I	J	K	L	M
1													
2	6	5	4	3	2	1							
3													
4	7	8	9	10	11	12							
5													
6	18	17	16	15	14	13							
7													
8	19	20	21	22	23	24							
9													
10	30	29	28	27	26	25							
11													
12	31	32	33	34	35	36							
13													


- A. Description of original monument and accessories and/or subsequent restoration:  
 1834 GLO; RISDON, D.S.; SET POST; W MAPLE 10 N57E 21LKS, SUGAR 10 N41W 62LKS  
 1903 BRUMLEY, C.S.; SET BY MEAS. RR COUPLING PIN STONE GLASS & CROCKERY; W. ASH 11 S30E 45 1/4, ELM 24 NORTH 187 1/2  
 1974 ROWE, P.S.#11192; LCRC PG.16; SET 1/2" ROD ON LINE BETWEEN SW COR. SEC.35 & NW COR. SEC.1 T12N-R7E AT RECORDED DIST. FROM W.; N15W 77.04' TAG 11192 IN T/P, NORTH 8.5' C/L RD, WEST 2644.62' SW COR SEC. 35, SOUTH 13.0' C/L DRAIN  
 1974 ROWE, P.S.#11192; SURVEY L.445, PG.763; SET 1/2" ROD; SAME WITS AS 1974 LCRC ABOVE  
 1979 BECK, P.S.#21559; SURVEY L.500, PG.448; FD 1/2" IRON; N60W 247.80' SE COR BRICK HOUSE, NORTH 8.00' C/L RD, WEST 2644.62' SW COR SEC 35

NOTE: THIS CORNER IS NOT COMMON WITH J-1 T12N-R7E

- B. Description of corner evidence found and/or method applied in restoring or reestablishing corner:  
 1996 ROWE ENG.; FIELD, P.S.#37276; FND. 1/2" ROD W/ CAP ABOVE LARGE WEDGE-SHAPED STONE W/ GLASS & CROCKERY ABOVE 1 1/4" IRON ROD 2.8' DEEP AT S. EDGE OF ASPH. RD. E-W & IN LINE WITH FIELD DIVISION TO N. RECOVERED 3 PREVIOUS WITNESSES WHICH INDICATE THAT FND ROD IS IN SAME POSITION AS 1974 LCRC CITED ABOVE

ACCEPTED FND. 1/2" ROD, STONE W/ CROCKERY & 1 1/4" ROD AS BEST EVIDENCE OF ORIGINAL CORNER POSITION

- C. Description of monument for corner and accessories established to perpetuate locating the position of the corner:  
 J-13 REMOVED 1/2" ROD, STONE & CROCKERY, DROVE 1 1/4" ROD DOWN SET STANDARD REMON MONUMENT STAMPED "J 13 T13N R7E" IN MON. BOX  
 N40°W, 26.42' 1/2" ROD W/CAP #37276  
 N53°E, 34.73' 1/2" ROD W/CAP #37276  
 EAST, 100.28' FND. P-K NAIL AT S. EDGE OF ASPH. RD. E-W  
 N62°W, 247.94' SE CORNER OF BRICK HOUSE

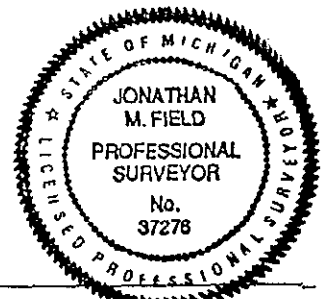

Signed by Jonathan M. Field Date 11-6-96  
 Surveyor's Michigan License No. 37276

APPROVED  
11-4-96  
*[Handwritten initials]*

FORM APPROVED BY MICHIGAN STATE BOARD OF LAND SURVEYORS, JAN. 28, 1971  
 REVISED MAY 14, 1976  
 REVISED JAN., 1983  
 ADAPTED FOR WORD PROCESSING MARCH, 1993

BRADLEYVILLE ROAD



SEC. 35  
T13N-R7E

GARNER ROAD

I-13  
179°56'32"

1903 BRUMLEY 2644.62'  
1974 REI 2644.62'  
1996 REI 2644.51'  
1834 GLO 2640'

J-13  
179°59'56"

1903 BRUMLEY 2644.62'  
1996 REI 2644.88'  
1834 GLO 2640'

K-13  
179°59'54"

VAN GIESEN ROAD

SEC. 2  
T12N-R7E

K-1