

**1996 REMONUMENTATION PROGRAM  
LAND CORNER RECORDATION CERTIFICATE**

Filing Requirement of Act 74, Mich. P.A. 1970

RECEIVED FOR RECORD

LIBER NO. \_\_\_\_\_ PAGE NO. 60

TWP. NO. Gilford

95 DEC 10 AM 8:56

*Jonathan M. Field*

TUSCOLA COUNTY  
REGISTER OF DEEDS

Register of Deeds Stamp & File Number

For corners in GILFORD TWP.

TUSCOLA

(County)

Located in:

Corner Code #

- 1. Public Land Survey T 13N R 07E  
T \_\_\_\_\_ R \_\_\_\_\_  
T \_\_\_\_\_ R \_\_\_\_\_  
T 12N R 7E
- 2. Property Controlling S \_\_\_\_\_ T \_\_\_\_\_ R \_\_\_\_\_  
in Section S \_\_\_\_\_ T \_\_\_\_\_ R \_\_\_\_\_
- 3. Miscellaneous S \_\_\_\_\_ T \_\_\_\_\_ R \_\_\_\_\_  
Property in Sec. S \_\_\_\_\_ T \_\_\_\_\_ R \_\_\_\_\_

L-13  
\_\_\_\_\_  
L-1  
\_\_\_\_\_  
\_\_\_\_\_  
\_\_\_\_\_

4. Lot No. \_\_\_\_\_, Recorded Plat \_\_\_\_\_

5. Private Claims \_\_\_\_\_

I, JONATHAN M. FIELD, in a field survey on MAY 15, 19 96, do hereby certify that under requirements of P.A. 74, Michigan P.A. of 1970, the corner points mentioned in lines 1 and 2 above were in conformance with regulations and rules therefore as required in the current manual of survey instructions of the United States Department of the Interior, Bureau of Land Management or by a decree of a Court of Law and/or that the corner points mentioned in lines 3, 4 and 5 above were in conformance with the rules of the Michigan Board of Land Surveyors or by a Decree of a Court of Law; established, re-established, monumented, re-monumented, recovered, found as expressed below:

	A	B	C	D	E	F	G	H	I	J	K	L	M
2	6	5	4	3	2	1							
3													
4	7	8	9	10	11	12							
5													
6	18	17	16	15	14	13							
7													
8	19	20	21	22	23	24							
9													
10	30	29	28	27	26	25							
11													
12	31	32	33	34	35	36							
13													

NOTE: Not more than 4 corners, all in the same town and range, may be recorded on this certificate.


- A. Description of original monument and accessories and/or subsequent restoration:
- 1834 GLO; RISDON, D.S.; SET POST; BEECH 12 N78W 37LKS, LYNN 10 N60E 39LKS
  - 1974 ROWE, P.S.#11192; LCRC PG.27; SET ROD ON LINE BETWEEN NE & NW CORNERS & ON OCCUPIED LINES N & S; EAST 2641.80' ROD AT NE COR. SEC.1, NORTH 5.8' C/L PVMNT. E-W, S60E 42.50' N. END 6" CMP
  - 1977 ROWE ENG.; DUNTON, P.S.#23503; SURVEY L.474, PG.267; ROD; EAST 2641.80' ROD @ NE COR SEC.1, NORTH 5.8' C/L PVMNT E-W, SOUTH 208.10' ROWE TAG IN P/P
  - 1984 LEDY ENG.; LEDY, P.S.#21575; SURVEY L.552, PG.1404; 1/2" BAR; S. 1.4' EDGE PVMNT., N.23.2' ANGLE IRON, SE 42.60' TOP CTR 6" CMP

NOTE: THIS CORNER IS COMMON WITH L-1 T12N-R7E

- B. Description of corner evidence found and/or method applied in restoring or reestablishing corner:
- 1996 ROWE ENG.; FIELD, P.S.#37276; FND. 1/2" ROD 6.5' S. OF C/L ASPH. RD. E-W & IN LINE WITH FIELD DIVISION N-S. RECOVERED 2 PREVIOUS WITNESSES WHICH INDICATE THAT FND ROD IS IN SAME POSITION AS 1974 LCRC CITED ABOVE

ACCEPTED FND. 1/2" ROD AS BEST EVIDENCE OF ORIGINAL CORNER POSITION

- C. Description of monument for corner and accessories established to perpetuate locating the position of the corner:
- L-13 REPLACED 1/2" ROD W/ STANDARD REMON MONUMENT STAMPED "L 13 T13N R7E" IN MON. BOX
- N39°E, 23.29' SET 1/2" ROD W/CAP #37276
  - N47°W, 26.79' SET 1/2" ROD W/CAP #37276
  - S77°W, 24.40' SET 1/2" ROD W/CAP #37276
  - S81°E, 26.98' SET 1/2" ROD W/CAP #37276
  - S01°E, 207.95' FND. NAIL W/TAG #11192 IN N. FACE P.POLE

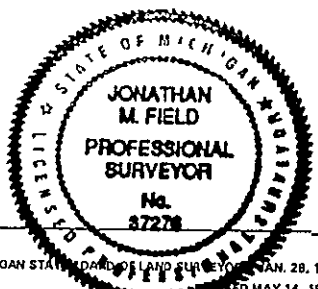

Signed by Jonathan M. Field Date 11-6-96  
Surveyor's Michigan License No. 37276

**APPROVED**  
11-4-96

FORM APPROVED BY MICHIGAN STATE BOARD OF LAND SURVEYORS JAN. 28, 1971  
REVISED MAY 14, 1976  
REVISED JAN., 1983  
ADAPTED FOR WORD PROCESSING MARCH, 1993

REMONUMENTATION  
MAY 20 1997

