MAY 0.5 1997

1996 REMONUMENTATION PROGRAM LAND CORNER RECORDATION CERTIFICATE


RECEIVED	ron n	COF	ξD
DESCRIPTED LIBER NO	~ P∆,6;	E NO.	<u>59</u>
"ILE NO	5117	ror d	-

ACTIO DISSESSAN

OOMARDDIE	HN Filing Requir	rement of Act 74, Mich. P.A. 19	70					·	
For corners in GILFORD TW	/P.			961	DEC L	0 48	1 8: 5	6	
TUSCOLA	Located In:	Corner Code #				• •••		~	
(County)		ļ		Dir	Sara .	ين پيس د و	رجيارا:{\		
1. Public Land Survey	13N R 07E T /4N R 7E T/4N R 8E T/3N R 8E	M-13 M-13 A-13				A gnu) .	
in Section S_	T R T R		leaist	er of D	eeds :	Stamn	& File l	Numb	٥٢
	T R T R	-					a i iie	- Tunnot	<i></i>
_			,						
4. Lot No, Recor	rded Plat			A D	~ ^	r r	.		
5. Private Claims			1	<u>А В</u>		E F	Б Н	i J K	LM
			2	6	5	4	3	2	1
I JONATHAN M PIPIN	in a finial account of the		3		-		ļ 	 	-
no neighby certify that under fegul	Irements of P.A. 74 Michigan 🛭	AY 17 19 96 P.A. of 1970, the corner points mentioned	4 5	7	8	9	10	11	12
current manual of survey instruction	conformance with regulations ons of the United States Dens	and rules therefore as required in the artment of the Interior, Bureau of Land rner points mentioned in lines 3, 4 and 5	6	18	17	16	15	14	13
TONG MELG III COMINITURINGE MIN	the fules of the Michigan Boar	rd of Land Suprevore or by a Doorse of a	7 8	19	20	21	22	23	24
expressed below:	-established, monumented, r	re-monumented, recovered, found as	9						
NOTE: Not more than 4 corn	sere all in the same town		10	30	29	28	27	26	25
on this certificate.	ers, an in the same town a	and range, may be recorded	11 12	31	32	22	34	25	
			13	J1	32	33	34	35	36
,									
1996 ROWE ENG.; FIELD	D, P.S.#37276; FND.	d applied in restoring or reestablishin. 2" PIPE IN MON BOX 23.5 10' S. OF C/L ASPH. ROAL	E.	OF C	/L AS	ВРН.	ROAD	и-з,	
ACCEPTED FND. PIPE IN	N MON BOX AS BEST E	EVIDENCE OF ORIGINAL CORNE	R PC	SITI	ои			-	
M-1 SET 5/8" ROD W/ CONC. IN MON BOX	STANDARD REMON CAP K	s established to perpetuate locating STAMPED "M 1 T13N R7E" 1	the p	osition E FN	of the	corne	r: Cased	, IN	,
	W CORNER OF W. WING W CORNER OF W. WING					4	D.F. A	NO PARK	Na.
N35°W, 86.90'S	ET NAIL W/TAG #207	09 IN E. FACE P.POLE					h was		
N59°W, 58.71' S	ET 1/2" ROD W/CAP	#37276			1	*/	JONAT M. FIE		* \
NOTE: THIS CORNER IS		14N-R7E, A-13 T14N-R8E, A		13N-1	R8E	C C E S	ROFES: SURVE	SIONAL YOR	38.610
igned by 12 to	m7-ilo	Date			. 1	6	3727	/6	
urveyorla Michigan Licanca M		-				7	POFES	510	1

STAJE BOARD OF LAN AND REVISED MAY 14, 1975
REVISED JAN., 1993
ADAPTED FOR WORD PROCESSING MARCH, 1993

APPROVED

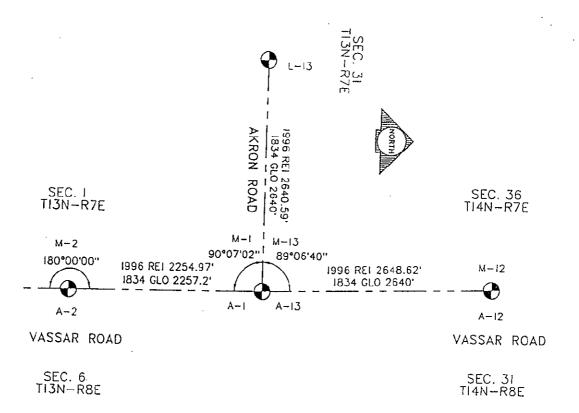

·