

1996 REMONUMENTATION PROGRAM  
LAND CORNER RECORDATION CERTIFICATE

Filing Requirement of Act 74, Mich. P.A. 1970

RECEIVED FOR RECORD  
LIBER NO. \_\_\_\_\_ PAGE NO. 58  
FILE NO. Gilford

96 DEC 10 AM 8:56

*Gregory Johnson*

TUSCOLA COUNTY  
REGISTER OF DEEDS

Register of Deeds Stamp & File Number

For corners in GILFORD TWP.

TUSCOLA

(County)

Located In:

Corner Code #

1. Public Land Survey T 13N R 07E  
T \_\_\_\_\_ R \_\_\_\_\_  
T 13N R 8E  
T \_\_\_\_\_ R \_\_\_\_\_
2. Property Controlling S \_\_\_\_\_ T \_\_\_\_\_  
in Section S \_\_\_\_\_ T \_\_\_\_\_  
3. Miscellaneous S \_\_\_\_\_ T \_\_\_\_\_  
Property in Sec. S \_\_\_\_\_ T \_\_\_\_\_

M-2 ✓  
A-2

4. Lot No. \_\_\_\_\_, Recorded Plat \_\_\_\_\_  
5. Private Claims \_\_\_\_\_

I, JONATHAN M. FIELD, in a field survey on MAY 17 19 95, do hereby certify that under requirements of P.A. 74, Michigan P.A. of 1970, the corner points mentioned in lines 1 and 2 above were in conformance with regulations and rules therefore as required in the current manual of survey instructions of the United States Department of the Interior, Bureau of Land Management or by a decree of a Court of Law and/or that the corner points mentioned in lines 3, 4 and 5 above were in conformance with the rules of the Michigan Board of Land Surveyors or by a Decree of a Court of Law; established, re-established, monumented, re-monumented, recovered, found as expressed below:

NOTE: Not more than 4 corners, all in the same town and range, may be recorded on this certificate.

	A	B	C	D	E	F	G	H	I	J	K	L	M
1													
2	6	5	4	3	2	1							
3													
4	7	8	9	10	11	12							
5													
6	16	17	16	15	14	13							
7													
8	19	20	21	22	23	24							
9													
10	30	29	28	27	26	25							
11													
12	31	32	33	34	35	36							
13													


- A. Description of original monument and accessories and/or subsequent restoration:  
1834 GLO; RISDON, D.S.; SET POST; B. ASH 14 N73W 37LKS, B. ASH 15 S77E 26LKS

NOTE: THIS CORNER IS COMMON WITH A-2 T13N-R8E

- B. Description of corner evidence found and/or method applied in restoring or reestablishing corner:  
1996 ROWE ENG.; FIELD, P.S.#37276; FND. NO EVIDENCE OF MONUMENT AT CORNER. REESTABLISHED POSITION FOR CORNER PROPORTIONATE TO GLO BETWEEN M-1 & M-3 T13N-R8E. POSITION THUS ESTABLISHED FALLS ON TREE LINE TO W. & ON C/L DITCH TO E, & IN BOTTOM OF N-S DITCH - SET WITNESS MONUMENT 15.00' N. OF M-2 ON LINE FROM M-2 T13N-R7E TO M-1 T13N-R7E

ACCEPTED PROPORTION AS BEST POSITION OF ORIGINAL CORNER.

- C. Description of monument for corner and accessories established to perpetuate locating the position of the corner:  
M-2 SET WITNESS MONUMENT, STANDARD REMON MONUMENT STAMPED "M 2 W.C. T13N R7E" 15.00' N. OF M-2  
S45°W, 57.00' SET 1/2" ROD W/CAP #37276  
N66°W, 14.12' SET 1/2" ROD W/CAP #37276  
S19°W, 37.97' SET 1/2" ROD W/CAP #37276  
S72°W, 54.25' SET NAIL W/REMON TAG IN S. FACE P. POLE  
ACCESSORIES ARE TO WIT. COR. MONUMENT NOT M-2

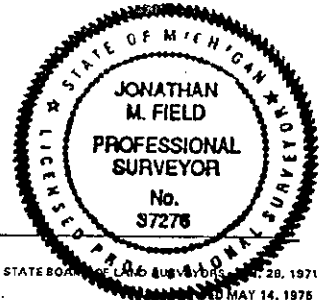

Signed by Jonathan M. Field Date 11-29-96  
Surveyor's Michigan License No. 37276

APPROVED  
11-27-96  
*[Signature]*

