

1996 REMONUMENTATION PROGRAM
LAND CORNER RECORDATION CERTIFICATE

RECEIVED FOR RECORD
INDEX NO. _____ PAGE NO. 53

Filing Requirement of Act 74, Mich. P.A. 1970

FILE NO. Callford

For corners in GILFORD TWP.
TUSCOLA
(County)

Located In:

Corner Code #

96 DEC 10 AM 8:56

Jonathan M. Field
TUSCOLA COUNTY
REGISTER OF DEEDS

- 1. Public Land Survey T 13N R 07E
T _____ R _____
T 13N R 8E
T _____ R _____
- 2. Property Controlling S _____ T _____ R _____
in Section S _____ T _____ R _____
- 3. Miscellaneous S _____ T _____ R _____
Property in Sec. S _____ T _____ R _____

M-7 ✓
A-7

Register of Deeds Stamp & File Number

4. Lot No. _____, Recorded Plat _____
5. Private Claims _____

	A	B	C	D	E	F	G	H	I	J	K	L	M
1													
2	6	5	4	3	2	1							
3													
4	7	8	9	10	11	12							
5													
6	18	17	16	15	14	13							
7													
8	19	20	21	22	23	24							
9													
10	30	29	28	27	26	25							
11													
12	31	32	33	34	35	36							
13													

I, JONATHAN M. FIELD, in a field survey on MAY 17 19 96
do hereby certify that under requirements of P.A. 74, Michigan P.A. of 1970, the corner points mentioned in lines 1 and 2 above were in conformance with regulations and rules therefore as required in the current manual of survey instructions of the United States Department of the Interior, Bureau of Land Management or by a decree of a Court of Law and/or that the corner points mentioned in lines 3, 4 and 5 above were in conformance with the rules of the Michigan Board of Land Surveyors or by a Decree of a Court of Law; established, re-established, monumented, re-monumented, recovered, found as expressed below.

NOTE: Not more than 4 corners, all in the same town and range, may be recorded on this certificate.


- A. Description of original monument and accessories and/or subsequent restoration:
1834 GLO; RISDON, D.S.; SET POST; ELM 14 S48W 24LKS, ELM 10 N35W 29LKS
1971 KAY ENG.; KAY, P.S.#14096; SURVEY L.1, PG.312; FND IRON; N45W 33.90' T/P, S45W 49.55' P/P WEST 1.5' C/L OF ROAD
1979 ROWE ENG.; ROWE, P.S.#11192; SURVEY L.497, PG.970; FND 1" PIPE IN MON BOX; N45W 34.20' TP MSHD TAG, S45W 50.06' P/P MSHD TAG, S30W 43.11' RD SIGN POST
1979 QUIST, P.S.#25868; LCRC PG.30; SAME OBJECT AND WITS AS 1979 SURVEY ABOVE

GLO NOTES FOR T13N-R8E INDICATE THAT THIS CORNER IS COMMON WITH A-7 T13N-R8E

- B. Description of corner evidence found and/or method applied in restoring or reestablishing corner:
1996 ROWE ENG.; FIELD, P.S.#37276; FND. 3/4" PIPE IN MON. BOX 1' S. OF C/L ASPH. ROAD E-W & 2.5' E. OF C/L ASPH. ROAD N-S. RECOVERED 1 PREVIOUS WITNESS WHICH INDICATES THAT FND PIPE IS IN SAME POSITION AS 1971 SURVEY CITED ABOVE

ACCEPTED FND. PIPE AS BEST EVIDENCE OF ORIGINAL CORNER POSITION

- C. Description of monument for corner and accessories established to perpetuate locating the position of the corner:
M-7 SET 5/8" ROD W/STANDARD REMON CAP STAMPED "M 7 T13N R7E" INSIDE FND PIPE ENCASED IN CONC. IN MON. BOX
S42°W, 50.18' FND. NAIL W/MSHD TAG IN SE FACE P.POLE
S44°E, 48.79' CENTER OF ROAD SIGN POST
N40°E, 28.26' SET 1/2" ROD W/CAP #37276
N47°W, 37.72' SET 1/2" ROD W/CAP #37276

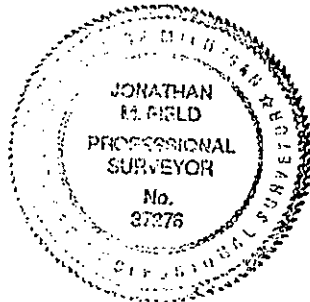

Signed by Jonathan M. Field Date 11-29-96
Surveyor's Michigan License No. 37276

APPROVED
11-27-96
P.B.E.
R.R.
1500

FAIRGROVE ROAD



SEC. 24
T13N-R7E

SEC. 13
T13N-R7E

M-8

M-7

M-6

179°59'26"

179°56'59"

179°56'50"

1996 REI 2635.00'
1834 GLO 2640'

1996 REI 2637.38'
1834 GLO 2640'



A-8

A-7

A-6

VASSAR ROAD

VASSAR ROAD

SEC. 19
T13N-R8E

SEC. 18
T13N-R8E