

1996 REMONUMENTATION PROGRAM
LAND CORNER RECORDATION CERTIFICATE

RECEIVED FOR RECORD
LIBER NO. _____ PAGE NO. 85
FILE NO. Fairgrove

Filing Requirement of Act 74, Mich. P.A. 1970

96 DEC 10 AM 8:59

For corners in FAIRGROVE TWP.

TUSCOLA Located In: _____ Corner Code # _____
(County)

1. Public Land Survey T 13N R 08E A-9
T _____ R _____
T 13N R 7E M-9
T _____ R _____

2. Property Controlling S _____ T _____ R _____
in Section S _____ T _____ R _____

3. Miscellaneous S _____ T _____ R _____
Property in Sec. S _____ T _____ R _____

Jonathan M. Field
TUSCOLA COUNTY
REGISTER OF DEEDS

Register of Deeds Stamp & File Number

4. Lot No. _____, Recorded Plat _____
5. Private Claims _____

	A	B	C	D	E	F	G	H	I	J	K	L	M
2	6	5	4	3	2	1							
3													
4	7	8	9	10	11	12							
5													
6	18	17	16	15	14	13							
7													
8	19	20	21	22	23	24							
9													
10	30	29	28	27	26	25							
11													
12	31	32	33	34	35	36							
13													

I, JONATHAN M. FIELD, in a field survey on MAY 17 19 96, do hereby certify that under requirements of P.A. 74, Michigan P.A. of 1970, the corner points mentioned in lines 1 and 2 above were in conformance with regulations and rules therefore as required in the current manual of survey instructions of the United States Department of the Interior, Bureau of Land Management or by a decree of a Court of Law and/or that the corner points mentioned in lines 3, 4 and 5 above were in conformance with the rules of the Michigan Board of Land Surveyors or by a Decree of a Court of Law, established, re-established, monumented, re-monumented, recovered, found as expressed below:

NOTE: Not more than 4 corners, all in the same town and range, may be recorded on this certificate.

- A. Description of original monument and accessories and/or subsequent restoration:
- 1834 GLO; RISDON, D.S.; SET AS M-9 OF THE ORIGINAL GOVERNMENT SURVEY OF T13N-R7E; POST; SUGAR 10 N68W 32LKS; BEECH 12 S64W 34LKS
 - 1971 ROWE ENG.; ROWE, P.S.#11192; SURVEY L.1, PG.321; FND NAIL SET RR SPIKE; N45W 46.93' NAIL W/CAP IN P.P., N60E 26.08' N COR NW WINGWALL, S60E 16.06' S COR SW WINGWALL, WEST 3.5' C/L RD
 - 1974 ROWE ENG.; ROWE, P.S.#11192; SURVEY L.443, PG.230; NO OBJECT STATED, NO WITS GIVEN
 - 1981 ROWE, P.S.#11192; LCRC PG.36; FND RR SPIKE; N45W 46.93' FND NAIL W/ CAP IN T/P, S45E 31.10' TOP E. RIVIT ON S END 6' CMP; N45E 46.15' CUT NOTCH IN N. END 6' CMP, WEST 3.5' C/L VASSAR RD
 - 1981 ROWE ENG. FOKENS, P.S.#21567; SURVEY L.520, PG.1298-99; SAME OBJECT & WITS AS 1981 SURVEY
 - 1987 MATONICH, P.S.#31598; LCRC PG.45; FND RR SPIKE; S55E 52.62' NAIL & TAG 11192 SW FACE P/P N45W 46.97' P/P, N40E 46.10' CHIS NOTCH N END CMP, S60E 31.14' CHIS NOTCH IN RIVET
 - 1989 DUNTON, P.S.#23503; SURVEY L.608, PG.1052; NO OBJECT STATED; NO WITS GIVEN


GLO NOTES FOR T13N-R8E INDICATE THAT THIS CORNER IS COMMON WITH M-9 T13N-R7E

- B. Description of corner evidence found and/or method applied in restoring or reestablishing corner:
- 1996 ROWE ENG.; FIELD, P.S.#37276; FND. RR SPIKE 4' E. OF C/L ASPH. ROAD N-S & 11'S. OF C/L ASPH. ROAD TO E. RECOVERED 2 PREVIOUS WITNESSES WHICH INDICATE THAT FND RR SPIKE IS IN SAME POSITION AS 1971 SURVEY CITED ABOVE

ACCEPTED FND. RR SPIKE AS BEST EVIDENCE OF ORIGINAL CORNER POSITION

- C. Description of monument for corner and accessories established to perpetuate locating the position of the corner:
- A-9 REPLACED FND RR SPIKE W/ STANDARD REMON MONUMENT STAMPED "M 9 T13N R7E" IN MON. BOX
 - N36°E, 46.08' FND. CHIS. NOTCH IN TOP N. END 72" CMP
 - S64°E, 31.13' FND. CHIS. + IN RIVIT IN TOP S. END 72" CMP
 - S58°E, 52.67' FND. NAIL W/TAG #11192 IN SW FACE P.POLE
 - N54°W, 47.31' SET NAIL W/REMON TAG IN NE FACE P.POLE

Signed by Jonathan M. Field Date 11-6-96
Surveyor's Michigan License No. 37276

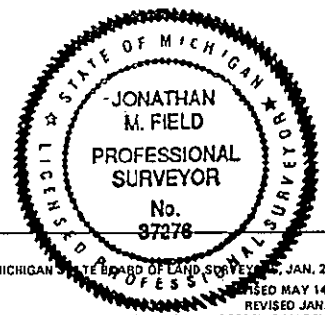

APPROVED
11-4-96

FORM APPROVED BY MICHIGAN STATE BOARD OF LAND SURVEYORS, JAN. 28, 1971
REVISED MAY 14, 1975
REVISED JAN., 1983
ADAPTED FOR WORD PROCESSING MARCH, 1993

MAY 20 1997

REGISTRATION

2-9



DECKERVILLE ROAD

SEC. 25
T13N-R7E

M-10

180°00'24"

1996 REI 2628.83'
1834 GLO 2640'

A-10

VASSAR ROAD

SEC. 24
T13N-R7E

M-8

179°59'26"

1996 REI 2636.46'
1834 GLO 2640'

A-8

VASSAR ROAD

SEC. 30
T13N-R8E

SEC. 19
T13N-R8E

M-9

180°00'36"

A-9