

**SURVEY &
REMONUMENTATION**

DEC 10 2 1993

COMMISSION

**1993 REMONUMENTATION PROGRAM
LAND CORNER RECORDATION CERTIFICATE
Filing Requirement of Act 74, Mich. P.A. 1970
FAIRGROVE TOWNSHIP**

For corners in
TUSCOLA
(County)

Located In: Corner Code //

- | | | |
|------------------------------------|--------------------------|-----|
| 1. Public Land Survey | T <u>13N</u> R <u>8E</u> | M-3 |
| | T _____ R _____ | |
| | T _____ R _____ | |
| | T _____ R _____ | |
| 2. Property Controlling in Section | S _____ T _____ R _____ | |
| | S _____ T _____ R _____ | |
| 3. Miscellaneous Property in Sec. | S _____ T _____ R _____ | |
| | S _____ T _____ R _____ | |

4. Lot No. _____, Recorded Plat _____
5. Private Claims _____

RECEIVED FOR RECORD
LIBER NO. _____ PAGE NO. 67
FILING NO. Fairgrove Twp
93 NOV -2 PM 3:56
VIRGINIA H. McLAUREN
TUSCOLA COUNTY
REGISTER OF DEEDS

Register of Deeds Stamp & File Number

I, Kenneth D. Dunton in a field survey on Aug. 28, 1993, do hereby certify that under requirements of P.A. 74, Michigan P.A. of 1970, the corner points mentioned in lines 1 and 2 above were in conformance with regulations and rules therefore as required in the current manual of survey instructions of the United States Department of the Interior, Bureau of Land Management or by a decree of a Court of Law and/or that the corner points mentioned in lines 3, 4 and 5 above were in conformance with the rules of the Michigan Board of Land Surveyors or by a Decree of a Court of Law; established, re-established, monumented, re-monumented, recovered, found as expressed below:

NOTE: Not more than 4 corners, all in the same town and range, may be recorded on this certificate.

	A	B	C	D	E	F	G	H	I	J	K	L	M
2	6	5	4	3	2								
3													
4	7	8	9	10	11	12							
5													
6	18	17	16	15	14	13							
7													
8	19	20	21	22	23	24							
9													
10	30	29	28	27	26	25							
11													
12	31	32	33	34	35	36							
13													

A. Description of original monument and accessories and/or subsequent restoration:

1821 G.L.O. Notes	Nov. 7, 1891 G. B. Felton, County Surveyor
Joseph Wampler, D.S.	From B.T.'s in 1877.
Set post cor. Sec. 1 & 12	B. Oak 6" N5°W 185.46'
Lynn 12" N84°W 9.90'	Sugar 3" S7°E 117.48'
Elm 12" S76 1/2°E 10.56'	North 2587.86' to cor. M-2
	West 2651.55' to cor. I-3

Note: Section A. continued on back of form.


B. Description of corner evidence found and/or method applied in restoring or reestablishing corner:

Found and accepted 3/4" I.D. pipe 18" long over 3/4" x 18" iron rod. Found 8" pointedstone 40" deep.

C. Description of monument for corner and accessories established to perpetuate locating the position of the corner:

Removed pipe & rod & placed standard monument with 2" brass cap stamped corner M-3, T13N-R8E. Placed monument box over monument.
N16°38'W 84.45' set T. C. Re-mon. tag & spike over remains #11192 tag & nail in E. face 40" Maple.
N17°11'E 166.85' set T. C. Re-mon. tag & spike in W. face p. pole.
S89°50'E 30.00' set 1/2" x 18" re-rod & cap #23503.
S37°18'E 82.97' set T. C. Re-mon. tag & spike over MSHD tag in NE face p. pole.
South 87.50' found 5/8" brass rod (bent North) at apparent corner A-5, T13N-R9E.

Signed by *Kenneth D. Dunton* Date Oct. 25, 1993
Surveyor's Michigan License No. 23503

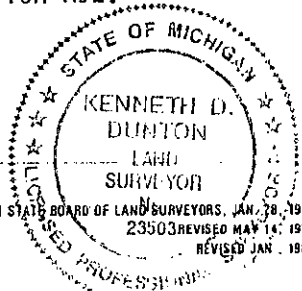

APPROVED
10-25-93 J.M.F.

Continued from Section A. on front of this form:

Nov. 1969 Witness card - source unknown

Set 1" rod & mon. box.

N20°W 61.91' 25" maple.

S35°E 83.00' p. p.

S40°W 52.90' road sign.

South 87.68' NW cor. Sec. 18, Almer Twp.

West 2660.81' N 1/4 cor. Sec. 12, Fairgrove Twp.

North 2583.93' E 1/4 cor. Sec. 1, Fairgrove Twp.

Oct. 6, 1988 Act 74, Fairgrove Township, Page 46 by Paul N. Brown, R.L.S. #33134.

Set large p. k. & tag #11192 using state highway survey plans showing previous measured distances.

South 87.68' SW cor., Sec. 7, T13N-R9E.

S35°E 82.74' found MSHD tag in NW face p. p.

N80°E 20.88' S. leg road sign post.

N20°W 84.27' set tag #11192 in E. face of 32" maple.

