

**SURVEY & REMONUMENTATION**

DEC 02 1993

**COMMISSION**

**1993 REMONUMENTATION PROGRAM  
LAND CORNER RECORDATION CERTIFICATE  
Filing Requirement of Act 74, Mich. P.A. 1970  
FAIRGROVE TOWNSHIP**

**COPY**

RECEIVED FOR RECORD  
LIBER NO. \_\_\_\_\_ PAGE NO. 60  
FILE NO. Fairgrove Twp.  
93 NOV - 2 PM 3:55  
VIRGINIA M. McLAUGHLIN  
TUSCOLA COUNTY  
REGISTER OF DEEDS

For corners in

TUSCOLA

(County)

Located In:

Corner Code //

- |                                    |               |              |         |
|------------------------------------|---------------|--------------|---------|
| 1. Public Land Survey              | T <u>13</u> N | R <u>8</u> E | M-10    |
|                                    | T _____       | R _____      |         |
|                                    | T _____       | R _____      |         |
|                                    | T _____       | R _____      |         |
| 2. Property Controlling in Section | S _____       | T _____      | R _____ |
|                                    | S _____       | T _____      | R _____ |
| 3. Miscellaneous Property in Sec.  | S _____       | T _____      | R _____ |
|                                    | S _____       | T _____      | R _____ |

Register of Deeds Stamp & File Number

4. Lot No. \_\_\_\_\_, Recorded Plat \_\_\_\_\_
5. Private Claims \_\_\_\_\_

	A	B	C	D	E	F	G	H	I	J	K	L	M
2	6	5	4	3	2								
3													
4	7	8	9	10	11	12							
5													
6	18	17	16	15	14	13							
7													
8	19	20	21	22	23	24							
9													
10	30	29	28	27	26	25							
11													
12	31	32	33	34	35	36							
13													

I, Kenneth D. Dunton, in a field survey on August 14, 1993, do hereby certify that under requirements of P.A. 74, Michigan P.A. of 1970, the corner points mentioned in lines 1 and 2 above were in conformance with regulations and rules therefore as required in the current manual of survey instructions of the United States Department of the Interior, Bureau of Land Management or by a decree of a Court of Law and/or that the corner points mentioned in lines 3, 4 and 5 above were in conformance with the rules of the Michigan Board of Land Surveyors or by a Decree of a Court of Law; established, re-established, monumented, re-monumented, recovered, found as expressed below:

NOTE: Not more than 4 corners, all in the same town and range, may be recorded on this certificate.

A. Description of original monument and accessories and/or subsequent restoration:

1821 G.L.O. Notes Joseph Wampler, D.S. Set 1/2 mile post Birch 12" S2°W 12.54' Maple 18" N80°W 3.96'	July 26, 1971 Witness card on file with Rowe Engineering Inc., Caro, MI by J. Kelley. Found railroad spike in place. West 32.27' nail & cap in t.p. S85°W 92.58' NE cor. garage @ #255. S40°W 130.91' SE cor. porch @ #255.
--	--

Note: Section A. continued on back of form.

B. Description of corner evidence found and/or method applied in restoring or reestablishing corner:

Found and accepted railroad spike with "+" chiseled on top.  
No other evidence found.

C. Description of monument for corner and accessories established to perpetuate locating the position of the corner:

Removed railroad spike and set standard monument with 2" brass cap stamped corner M-10, T13N-R8E. Placed monument box over monument.  
S00°23'15"W 170.60' found railroad spike at apparent corner A-12, T13N-R9E.  
S53°23'W 91.89' set T. C. Re-mon. tag & spike in SE face 12" maple.  
S89°46'W 32.36' found bottle cap & nail in E. face t. pole stub. Set T. C. Re-mon. tag & spike above cap & nail found.  
N89°00'W 33.00' found 1/2" rod & cap #11192.  
S89°00'E 33.00' set 1/2" x 18" re-rod & cap #23503.

Signed by

*Kenneth D. Dunton*


Date Oct. 18, 1993

Surveyor's Michigan License No. 23503

**APPROVED**  
10-18-93

*Handwritten initials and date*

FORM APPROVED BY MICHIGAN

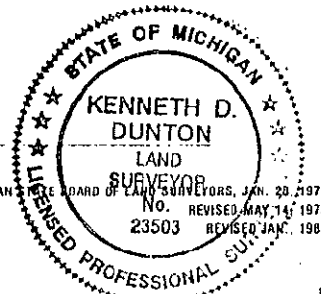

Continued from Section A. on front of this form:

July 30, 1971 Survey Liber 1 - Page 184 by David T. Rowe, R.L.S. #11192. Found R. R. spike. Accessories same as witness card of July 26, 1971.

July 5, 1972 Act 74, Fairgrove Township, Page 19 by David T. Rowe, R.L.S. #11192. Found R.R. spike in place. Accessories same as witness card of 7-26-, 1971 & Survey L-1, P-184.

Sept. 9, 1972 Survey Liber 433, Pages 162 & 163 by David T. Rowe, R.L.S. #11192. Found R. R. spike in place. Accessories same as witness card of 7-26, 1971, Survey L-1, P-184 and Act 74, Fairgrove Twp., Page 19.

August 27, 1974 Surveys Liber 445 - Pages 775 & 776 and Liber 450 - Page 592 by David T. Rowe, R.L.S. #11192. Accessories same as all previous surveys, Act 74 & witness card.

Dec. 6, 1974 Survey Liber 451 - Page 146 by James A. Beck, R.L.S. #21559. No mention of object found or set. No accessories given.

Nov. 25, 1985 Surveys Liber 567 - Pages 578 & 579 by Kenneth D. Dunton, R.L.S. #23503. Found R. R. spike.

West 32.27' t. p.

S40°W 130.9' cor. porch.

S45°W 82.0' 6" maple.

