

**SURVEY & REMONUMENTATION**

MAR 05 1998

SECTION

**COPY**

1997 REMONUMENTATION PROGRAM  
**LAND CORNER RECORDATION CERTIFICATE**  
 Filing Requirement of Act 74, Mich. P.A. 1970

RECEIVED FOR RECORD  
 LIBER NO. \_\_\_\_\_ PAGE NO. 7

FILE NO. ALMER TWP.  
 97 NOV 25 PM 3:46

*[Signature]*  
 TUSCOLA COUNTY  
 REGISTER OF DEEDS

For corners in Almer Township

<u>Tuscola</u> (County)	Located in:	Corner Code #
1. Public Land Survey	T <u>13</u> NR <u>09</u> E	<u>K-13</u>
	T _____ R _____	_____
	T _____ R _____	_____
	T _____ R _____	_____
2. Property Controlling in Section	S _____ T _____ R _____	_____
	S _____ T _____ R _____	_____
3. Miscellaneous Property in Sec.	S _____ T _____ R _____	_____
	S _____ T _____ R _____	_____

Register of Deeds Stamp & File Number

4. Lot No. \_\_\_\_\_, Recorded Plat \_\_\_\_\_  
 5. Private Claims \_\_\_\_\_

I, Kenneth D. Dunton, in a field survey on Nov. 9, 1997 do hereby state that under requirements of P.A. 74, Michigan P.A. of 1970, the corner points mentioned in lines 1 and 2 above were in conformance with regulations and rules therefore as required in the current manual of survey instructions of the United States Department of the Interior, Bureau of Land Management or by a decree of a Court of Law and /or that the corner points mentioned in lines 3, 4 and 5 above were in conformance with the rules of the Michigan Board of Land Surveyors or by a Decree of a Court of Law; established, re-established, monumented, recovered, found as expressed below:

NOTE: Not more than 2 corners, all in the same town and range, may be recorded on this certificate.

A	B	C	D	E	F	G	H	I	J	K	L	M
1												
2	6		5		4		3		2		1	
3												
4	7		8		9		10		11		12	
5												
6	18		17		16		15		14		13	
7												
8	19		20		21		22		23		24	
9												
10	30		29		28		27		26		25	
11												
12	31		32		33		34		35		36	
13												

**A. Description of original monument and accessories and/or subsequent restoration:**

Dec. 26, 1834 Hervey Parke, D.S. Set post corner Sections 35 & 36. Hemlock 10" N66°E 12 links Cedar 8" N45 1/2°W 19 links. April 7, 1980 Survey L-508, P-263 through 267 by Leach, L.S. #7236. Set "T" iron. East 58.00' to NW cor. Sec. 1, T12N-R9E (iron & cap #15399), West 328.26' "T" iron & cap #7236, North 1325.55' "T" iron & cap #7236. Oct. 4, 1985 Survey L-554, P-285 & 286 by Emery. "T" iron (found). Accessories same as Survey L-508, P-263 through 267. May 17, 1992 Survey L-636, P-895 through 898 by Field, L.S. #37276. Fnd. "T" iron. N40°E 16.92' set nail & tag #20709 NW face 10" Birch, S40°W 24.49' set nail/tag SE face 30" Cottonwo S30°E 33.77' set nail/tag #20709 NE face 12" Birch, East 57.88' fnd. rod @ NW cor. Sec. 1, Section A con't on back of form. T12N-R9E.

**B. Description of corner evidence found and/or method applied in restoring or reestablishing corner:**


Found "T" iron with cap #7236 (Leach) and one accessory that indicates the corner found is in the same position as the 1980 survey. Accepted "T" iron as the best evidence of the original corner.

**C. Description of monument for corner and accessories established to perpetuate locating the position of the corner:**

Removed "T" iron and placed concrete monument with standard brass cap stamped K-13, T13N-R9E. S10°E 26.70' set T. C. Remon. tag & spike in W. face 9" Maple. N70°E 2.27' set T. C. Remon. tag & spike in NW face 10" Ash. S30°W 24.53' fnd. spike in SE face 34" Cottonwood. N45°E 16.88' fnd. nail & tag in NW face 12" dead Birch (no data on tag). S35°E 33.79' fnd. nail & tag in NE face 15" dead Birch (no data on tag). East 57.89' fnd. 1/2" iron rod at apparent cor. K-1, T12N-R9E.

Signed by *[Signature]* Date 11-24-97  
 Surveyor's Michigan License No. 23503

APPROVED  
11-24-97  
*[Signatures]*

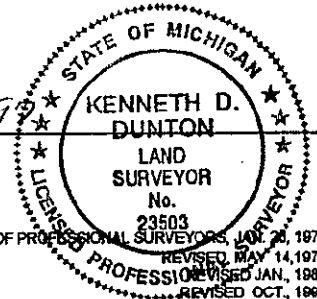

Section A con't from front of form:

May 5, 1994 Survey L-662, P-194 & 195 by Field, L.S. #37276. Object and accessories same as Survey L-636, P-895 through 898:

