

**SURVEY & REMONUMENTATION**

MAR 05 1998

SECTION \_\_\_\_\_

**COPY**

1997 REMONUMENTATION PROGRAM  
**LAND CORNER RECORDATION CERTIFICATE**  
 Filing Requirement of Act 74, Mich. P.A. 1970

RECEIVED FOR RECORD  
 LIBER NO. \_\_\_\_\_ PAGE NO. # 74

FILE NO. ALMER TWP.  
 97 NOV 25 PM 3:46

For corners in Almer Township

| <u>Tuscola</u><br>(County)         | Located In:               | Corner Code # |
|------------------------------------|---------------------------|---------------|
| 1. Public Land Survey              | T <u>13N</u> R <u>09E</u> | <u>L-13</u>   |
|                                    | T ___ R ___               | _____         |
|                                    | T ___ R ___               | _____         |
|                                    | T ___ R ___               | _____         |
| 2. Property Controlling in Section | S ___ T ___ R ___         | _____         |
|                                    | S ___ T ___ R ___         | _____         |
| 3. Miscellaneous Property in Sec.  | S ___ T ___ R ___         | _____         |
|                                    | S ___ T ___ R ___         | _____         |

*[Signature]*  
 TUSCOLA COUNTY  
 REGISTER OF DEEDS

Register of Deeds Stamp & File Number

4. Lot No. \_\_\_\_\_, Recorded Plat \_\_\_\_\_  
 5. Private Claims \_\_\_\_\_

I, Kenneth D. Dunton, in a field survey on Nov. 8, 1997 do hereby state that under requirements of P.A. 74, Michigan P.A. of 1970, the corner points mentioned in lines 1 and 2 above were in conformance with regulations and rules therefore as required in the current manual of survey instructions of the United States Department of the Interior, Bureau of Land Management or by a decree of a Court of Law and /or that the corner points mentioned in lines 3, 4 and 5 above were in conformance with the rules of the Michigan Board of Land Surveyors or by a Decree of a Court of Law; established, re-established, monumented, recovered, found as expressed below:

NOTE: Not more than 2 corners, all in the same town and range, may be recorded on this certificate.

|    | A | B  | C | D  | E | F  | G | H  | I | J  | K | L  | M |
|----|---|----|---|----|---|----|---|----|---|----|---|----|---|
| 1  |   |    |   |    |   |    |   |    |   |    |   |    |   |
| 2  |   | 6  |   | 5  |   | 4  |   | 3  |   | 2  |   | 1  |   |
| 3  |   |    |   |    |   |    |   |    |   |    |   |    |   |
| 4  |   | 7  |   | 8  |   | 9  |   | 10 |   | 11 |   | 12 |   |
| 5  |   |    |   |    |   |    |   |    |   |    |   |    |   |
| 6  |   | 18 |   | 17 |   | 16 |   | 15 |   | 14 |   | 13 |   |
| 7  |   |    |   |    |   |    |   |    |   |    |   |    |   |
| 8  |   | 19 |   | 20 |   | 21 |   | 22 |   | 23 |   | 24 |   |
| 9  |   |    |   |    |   |    |   |    |   |    |   |    |   |
| 10 |   | 30 |   | 29 |   | 28 |   | 27 |   | 26 |   | 25 |   |
| 11 |   |    |   |    |   |    |   |    |   |    |   |    |   |
| 12 |   | 31 |   | 32 |   | 33 |   | 34 |   | 35 |   | 36 |   |
| 13 |   |    |   |    |   |    |   |    |   |    |   |    |   |

A. Description of original monument and accessories and/or subsequent restoration:

Dec. 26, 1834 Hervey Parke, D.S. Set quarter section post. Hemlock 20" N56°W 26 links, Hemlock 8" N85°E 11 links. Feb. 27, 1975 Survey L-451, P-166 through 169 by Beck, L.S. #21559. Occupied S 1/4 cor. Sec. 36, Almer Twp. New fence post. Set spike in top center-fence lines East, South & North. N85°E 27.00' spike 7" Cedar, N60°W 39.08' spike 6" Cedar, S45°W 13.72' spike 8" Poplar. April 7, 1980 Survey L-508, P-263 through 267 by Leach, L.S. #7236. Spike found top fence cor. Set by Beck 1975, S 1/4 cor. Sec. 36, T13N-R9E. Accessories same as Survey L-451, P-166 through 169. May 23, 1984 L.C.R.C. Page 47 by Emery, L.S. #24593.

Section A can't on back of form.

B. Description of corner evidence found and/or method applied in restoring or reestablishing corner:


Found 1/2" iron rod & cap #24593 with remains of wood post below and four accessories that indicate the corner found is in the same position as the 1984 L.C.R.C. Accepted 1/2" iron as the best evidence of the original corner.

C. Description of monument for corner and accessories established to perpetuate locating the position of the corner:

Removed 1/2" iron rod & remains of wood post and set concrete monument with standard brass cap stamped L-13, T13N-R9E.  
 S40°W 2.5'± found. 8" corner post with spike in top center.  
 S45°W 16.37' found. spike in NW face 15" dead Poplar.  
 N55°W 39.23' found. spike in E. face 10" db1. Hemlock, set T.C. Remon. tag & spike above.  
 N89°E 25.05' found. spike in N. face 10" Hemlock, set T. C. Remon. tag & spike above.  
 S55°E 17.03' set T. C. Remon. tag & spike in N. face twin 15" Maples.  
 East 27.55' found. 1/2" iron rod & cap #24593 at apparent cor. L-1, T12N-R9E.

Signed by [Signature] Date 11-24-97  
 Surveyor's Michigan License No. 23503

APPROVED  
11-24-97  
*[Signatures]*

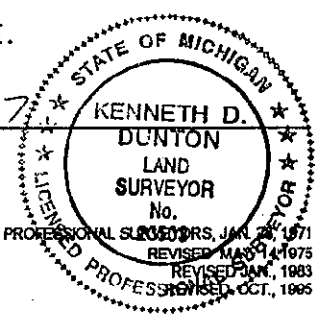

Section A con't. from front of form:

Found remains of wood post in high groundwater conditions and placed 1/2" dia. re-rod in remains. N88°E 25.06' fnd. nail in 10" Hemlock, N89°E 27.49' 1/2" re-rod set at N 1/4 cor. Sec. 1, T12N-R9E, S50°W 16.35' fnd. nail in 12" Poplar, N45°W 39.32' fnd. nail in 8" trunk of dbl. Hemlock. Oct. 4, 1985 Survey L-554, P-285 & 286 by Emery, L.S. #24593. 1/2" diameter re-rod (found). Accessories same as L.C.R.C. Page 47.

