
MAR 0 2 1999

SECTION

1998 REMONUMENTATION PROGRAM

LAND CORNER RECORDATION CERTIFICATE Filing Requirement of Act 74, Mich. P.A. 1970

For corners in Almer Township	TACL 74, MICH. P.A. 1970
Tuscola Located in: Corner Code:	is a let
(County)	PA PR
1. Public Land Survey	——————————————————————————————————————
TR	- 59 ETT - 50 ETT - 5
TR	
in Section	
Property in Sec. S TR	Register of Deeds Stamp & File Number
	Name
4. Lot No, Recorded Plat 5. Private Claims	ABCDEFGHIJKLM
	2 5 4 3 - 2 - 1
, <u>Kenneth D. Dunton</u> , in a field survey on <u>June 6</u> , 1998	3
requirements of P.A. 74, Michigan P.A. of 1970, the corner points mentioned in (lines 1 and 2 above were in
conformance with regulations and rules therefore as required in the current manual United States Department of the Interior, Bureau of Land Management or by a deci	ree of a Court of Law and /or 6 10 17 16 18 14 13
that the corner points mentioned in lines 3, 4 and 5 above were in conformance w Board of Land Surveyors or by a Decree of a Court of Law; established, re	ith the rules of the Michigan -established, monumented,
ecovered, found as expressed below:	8 19 20 21 22 23 24 4
NOTE: Not more than 2 comers, all in the same town and range, may be on this certificate.	recorded 9 10 30 29 28 27 26 25
	11
A. Description of original monument and accessories and/or subsequen	nt restoration:
27.08' nail & disk 14" Maple, N35°W 48.90' nai 15" Pine, East 2.5' centerline of pavement. No	27.07' 15" Maple, S35°W 86.66' NE cor. house. mes A. Beck, P.S. #21559, fnd. 1/2" re-rod, West l & disk 16" Maple, S30°E 66.51' R.L.S. tag 11192 ov. 10, 1982 Survey, L-529, P-534 by Richard R. me as Survey L-447, P-418 & 419. June 1992, L.C.R.C. on pipe in monument box, West 26.9' 16" Maple, tag #11192 in 15" Pine.
Found 1" axle shaft in monument box. Accepted corner.	d 1" shaft as the best evidence of the original
Corner M-8, T13N-R9E is common with Corner A-8	, T13N-R10E.
•	•
Description of monument for corner and accessories established to p	perpetuate locating the position of the corner:
Drove axle shaft down & placed 1" I.D. pipe & shaft. Stamped brass cap M-8, Tl3N-R9E and end N27°W 49.03' set T.C. Remon. tag & spike over N85°W 26.85' set T.C. Remon. tag & spike in S S35°E 66.25' set T.C. Remon. tag & spike over N85°E 75.89' fnd. old steel axle shaft at W. East 4' centerline of N-S pavement.	cased cap, rod & pipe in concrete in mon. box. nail & disk fnd. in E. face 18" Maple face 18" Maple. 11192 tag fnd. in SW face 15" Pine.
Signed by	Date //- 23-95 KENNETH D. *
Surveyor's Michigan License No. 23503	まず IAMD 含ま
APPROVED J.R.E. 11-23-98 R.P.B.	SURVEYOR No. 23503 FORM APPROVED BY MICHIGAN STATE BOARD OF PROFESSIONAL SURVEYORS, JAN. 28, 1971 REVISED MAY 14,1975
gm4.	REVISED JOH, 1983 REVISED COT., 1995

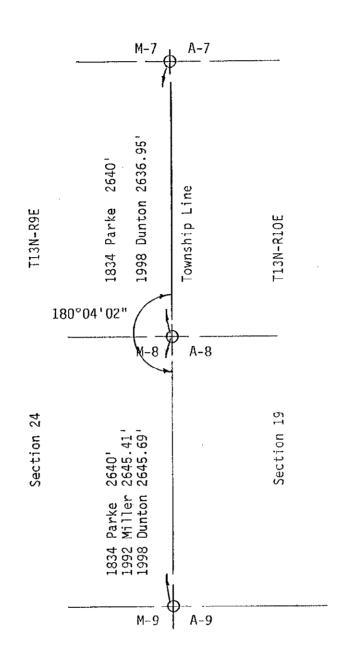

SURVEY & REMONUMENTATION

MAR 02 1999

SECTION