

SURVEY & REMONUMENTATION

MAR 02 1999

1998 REMONUMENTATION PROGRAM

SECTION

LAND CORNER RECORDATION CERTIFICATE
Filing Requirement of Act 74, Mich. P.A. 1970

For corners in Ellington Township

<u>Tuscola</u> (County)	Located In:	Corner Code #
1. Public Land Survey	<u>T13N R10E</u>	<u>A-11</u>
	T <u> </u> R <u> </u>	<u> </u>
	T <u> </u> R <u> </u>	<u> </u>
	T <u> </u> R <u> </u>	<u> </u>
2. Property Controlling in Section	S <u> </u> T <u> </u> R <u> </u>	<u> </u>
	S <u> </u> T <u> </u> R <u> </u>	<u> </u>
3. Miscellaneous Property in Sec.	S <u> </u> T <u> </u> R <u> </u>	<u> </u>
	S <u> </u> T <u> </u> R <u> </u>	<u> </u>

RECEIVED FOR RECORD
LIBER NO. _____ PAGE NO. 115
FILE NO. ELLINGTON TWP
93 NOV 30 PM 4:00
Angie M. Brown
TUSCOLA COUNTY
REGISTER OF DEEDS

Register of Deeds Stamp & File Number

4. Lot No. _____, Recorded Plat _____
5. Private Claims _____

I, Kenneth D. Dunton, in a field survey on June 5, 1998 do hereby state that under requirements of P.A. 74, Michigan P.A. of 1970, the corner points mentioned in lines 1 and 2 above were in conformance with regulations and rules therefore as required in the current manual of survey instructions of the United States Department of the Interior, Bureau of Land Management or by a decree of a Court of Law and for that the corner points mentioned in lines 3, 4 and 5 above were in conformance with the rules of the Michigan Board of Land Surveyors or by a Decree of a Court of Law; established, re-established, monumented, recovered, found as expressed below:

NOTE: Not more than 2 corners, all in the same town and range, may be recorded on this certificate.

	A	B	C	D	E	F	G	H	I	J	K	L	M
1													
2	6			5			4			3		2	1
3													
4	7			8			9			10		11	12
5													
6	18			17			16			15		14	13
7													
8	19			20			21			22		23	24
9													
10	30			29			28			27		26	25
11													
12	31			32			33			34		35	36
13													

A. Description of original monument and accessories and/or subsequent restoration:

G.L.O. Notes Dec. 28, 1834 by H. Parke, D.S. Set post corner Sections 25 & 36, Hemlock 6" N37 1/2°W 15 links, Sugar 8" S32°W 32 links. Aug. 28, 1971 Survey L-1, P-220 by Robert G. Kay, P.S. #14096, fnd. 1" iron, South 30.8' corner post, S45°E 55.2' Butternut, N45°E 51.3' corner post. Sept. 10, 1971 Survey L-1, P-187, by David T. Rowe, P.S. #11192, fnd. boat spike, South 30.86' P.K. nail in anchor post, S40°E 55.01' P.K. in 12" tree, N45°W 45.14' road sign. May 23, 1972, L.C.R.C. Page 4 by David T. Rowe, P.S. #11192, fnd. 2" pipe in mon. box, accessories same Survey L-1, P-187. June 6, 1972, Surveys L-1, P-516, 520 & 521 by David T. Rowe, P. S. #11192, object and accessories same as L.C.R.C. Page 4.

Section A con't on back of form.

B. Description of corner evidence found and/or method applied in restoring or reestablishing corner:

2" pipe in
Found 1/2" iron rod in mon. box. Accepted found 1/2" iron as the best evidence of the original corner.


Corner A-11, T13N-R10E is common with Corner M-11, T13N-R9E.

C. Description of monument for corner and accessories established to perpetuate locating the position of the corner:

Removed 1/2" iron rod and placed 5/8" iron rod with standard brass cap stamped M-11, T13N-R9E. Placed rod and cap in 2" pipe in existing mon. box and encased in concrete.
N35°E 76.41' set remon. tag & spike in SE face power pole.
S60°E 56.24' set remon. tag & spike in NE face 24" Pignut Hickory.
S03°E 51.52' set remon. tag & spike in East face 18" White Pine.
N30°W 84.95' center of 4" Walnut.
N40°W 45.20' center of road sign post.

Signed by *Kenneth D. Dunton*
Surveyor's Michigan License No. 23503

Date 11-25-98

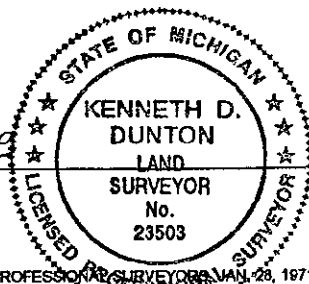

APPROVED
11-25-98
J.B.E.
J.M.A.

Section A con't.

Sept. 26, 1972, L.C.R.C. Page 14 by Sheldon R. Brown, P.S. #17613, fnd. pot & pipe, anchor post South 30.88', power pole N40°E 76.06', 24" tree S50°E 55.20'. Oct. 4, 1972, Survey L-2, P-88 by Sheldon R. Brown, P.S. #17613, corner labeled incorrectly as NE cor. Sec. 25 but object and accessories same as L.C.R.C. for SE Cor. Section 25, Page 14. Feb. 3, 1973, Surveys L-2, P-323 & 325 by Robert G. Kay, P.S. #14096, no object mentioned, accessories same as L-1, P-220. July 10, 1974, Survey L-445, P-744 by David T. Rowe, P. S. #11192, no mention of object or accessories. Nov. 13, 1974, Survey L-451, P-144 by David T. Rowe, P. S. #11192, fnd. 2" pipe in mon. box, accessories same as L-1, P-516. Dec. 18, 1974 Survey L-453, P-55 & 56 by James A. Beck, P.S. #21559, fnd. 1" iron, accessories same as L-2, P-325. May 27, 1976 Surveys L-463, P-983, 984 & 985 by Robert G. Kay, P.S. #14096, object and accessories same as L-453, P-55 & 56. Sept. 12, 1977 Survey L-478; P-482 & 483 by James A. Beck, P.S. #21559, no mention of object found or set or accessories.

June 15, 1978 Survey L-488, P-884, 885 & 886 by Kenneth D. Dunton, P.S. #23503 with Rowe Eng., object and accessories same as Survey L-1, P-220. May 1, 1979, Surveys L-500, P-445 by Earl E. Gravlin, P. S. #23510, no mention of object found or set or accessories.

June 11, 1979 Survey L-500, P-452 by James A. Beck, P.S. #21559, no mention of object found or set, accessories same as L-478, P-482 & 483 M-11, 13-9 & A-11, 13-10. June 11, 1979 Survey L-499, P-631 thru 634 by James L. Quist, P.S. #25868, no mention of object found or set or accessories. April 18, 1985 Surveys L-553, P-058 & 059 by Earl E. Gravlin, P. S. #23510, found 1" iron, accessories same as Survey L-1, P-220. Jan. 28, 1986 Survey L-574, P-1178 by Lionel Roy Emery, P.S. #24593, found pipe in mon. box, S40°E 55.18' - P.K. nail in tree, South 30.82' - P.K. nail in anchor post, N45°W 45.0' - road sign post. May 20, 1987 Survey L-577, P-368 by Earl E. Gravlin, P.S. #23510, no mention of object found or set, accessories same as Survey L-500, P-445. May 5, 1993 Survey L-556, P-335 by Earl E. Gravlin, P.S. #23510, found iron, accessories same as Survey L-577, P-368. Aug. 18, 1995 Surveys L-695, P-483, 484 & 503 thru 507, found 2" pipe in mon. box, S40°E 55.18' fnd. P.K. nail in 14" tree, South 30.82' fnd. P.K. nail in fence post, N45°W 45.0' road sign post, N45°W 47.15' fnd. 1/2" rod, N45°E 76.05' fnd. nail & tag #11192 in p. pole.

**SURVEY &
REMONUMENTATION**
MAR 02 1999
SECTION

