

**1997 REMONUMENTATION PROGRAM
LAND CORNER RECORDATION CERTIFICATE**
Filing Requirement of Act 74, Mich. P.A. 1970

COPY

RECEIVED FOR RECORD
LIBER NO. _____ PAGE NO. _____
FILE NO. #42
ELLINGTON TOWNSHIP
97 OCT -7 PM 3:03

Jonathan M. Field
TUSCOLA COUNTY
REGISTERED SURVEYOR

For corners in: **ELLINGTON TWP.**

<u>TUSCOLA</u> (County)	Located In:	Corner Code #
1. Public Land Survey	T <u>13N</u> R <u>10E</u>	<u>F-13</u>
	T _____ R _____	_____
	T _____ R _____	_____
	T _____ R _____	_____
2. Property Controlling in Section	S _____ T _____ R _____	_____
	S _____ T _____ R _____	_____
3. Miscellaneous Property in Sec.	S _____ T _____ R _____	_____
	S _____ T _____ R _____	_____

Register of Deeds Stamp & File Number

4. Lot No. _____, Recorded Plat _____
5. Private Claims _____

I, JONATHAN M. FIELD, in a field survey on JULY 24 19 97, do hereby certify that under requirements of P.A. 74, Michigan P.A. of 1970, the corner points mentioned in lines 1 and 2 above were in conformance with regulations and rules therefore as required in the current manual of survey instructions of the United States Department of the Interior, Bureau of Land Management or by a decree of a Court of Law and/or that the corner points mentioned in lines 3, 4 and 5 above were in conformance with the rules of the Michigan Board of Land Surveyors or by a Decree of a Court of Law; established, re-established, monumented, re-monumented, recovered, found as expressed below:

1	A	B	C	D	E	F	G	H	I	J	K	L	M
2		6	5	4	3	2	1						
3													
4		7	8	9	10	11	12						
5													
6		18	17	16	15	14	13						
7													
8		19	20	21	22	23	24						
9													
10		30	29	28	27	26	25						
11													
12		31	32	33	34	35	36						
13													

NOTE: Not more than 4 corners, all in the same town and range, may be recorded on this certificate.

A. Description of original monument and accessories and/or subsequent restoration:
1834 GLO; PARKE, D.S.; SET 1/4 SEC. POST; PINE 28 N82 1/2E 63LKS., HEMLOCK 12 N69W 10LKS.

B. Description of corner evidence found and/or method applied in restoring or reestablishing corner:
1997 ROWE; FIELD, PS#37276; FND. NO EVIDENCE OF MONUMENT AT CORNER POSITION; RE-ESTABLISHED CORNER POSITION BY SINGLE PROPORTION BETWEEN CORNERS E-13 AND G-13 T13N-R10E;


ACCEPTED SINGLE PROPORTION AS BEST RE-ESTABLISHMENT OF ORIGINAL CORNER POSITION

C. Description of monument for corner and accessories established to perpetuate locating the position of the corner:
F-13 SET STD. REMON. MONUMENT STAMPED F 13 T13N R10E
S55°E, 47.01' SET NAIL W/TAG #37276 IN SW FACE TRIPLE 5" MAPLE
S55°W, 27.09' SET NAIL W/TAG #37276 IN NW FACE MUTLI 5" MAPLE
N65°W, 32.98' SET NAIL W/TAG #37276 IN S. FACE 7" & 14" MAPLE
NORTH, 26.09' SET P-K NAIL W/TAG #37276 IN E. FACE FENCE CORNER POST

Signed by *Jonathan M. Field* Date 9-24-97
Surveyor's Michigan License No. 37276

APPROVED
9-22-97

M. Field
R.B.

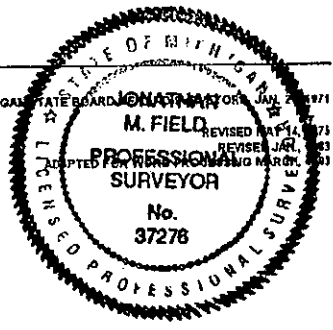

**SURVEY &
REMONUMENTATION**

NOV 26 1997

COMMISSION

