
## 1997 REMONUMENTATION PROGRAM LAND CORNER RECORDATION CERTIFICATE

1997 REMONUMENTATION PROGRAM LAND CORNER RECORDATION CERTIFICATE Filing Requirement of Act 74, Mich. P.A. 1970	RECEIVED RECEIVED FILENO #1 97 DC1 TUSCO REGIS
For corners in: ELLINGTON TWP.  TUSCOLA Located in: Corner Code #  (County)  1. Public Land Survey T 13N R 10E H-13	FOR RECORD PAGE NO. P
T	
4. Lot No, Recorded Plat	7 8 9 10 11 -12
I, JONATHAN M. FIELD , in a field survey on JULY 24 19 97 do hereby certify that under requirements of P.A. 74, Michigan P.A. of 1970, the corner points mentioned in lines 1 and 2 above were in conformance with regulations and rules therefore as required in the current manual of survey instructions of the United States Department of the Interior, Bureau of Land Management or by a decree of a Court of Law and/or that the corner points mentioned in lines 3, 4 and 5 Management or by a decree of a Michigan Board of Land Surveyors or by a Decree of a above were in conformance with the rules of the Michigan Board of Land Surveyors or by a Decree of a monumented, re-monumented, recovered, found as expressed below:  NOTE: Not more than 4 corners, all in the same town and range, may be recorded on this certificate.	31 32 33 34 35 36
A. Description of original monument and accessories and/or subsequent restoration: 1834 GLO; PARKE, D.S.; SET 1/4 SEC. POST; MAPLE 11 N75E 30LKS., HEMLOCK 16 1977 CASE SURVEYING; CASE, P.S.#15399; SURVEY L.475 PG.338; FND. MOUND O CENTER SET 3/4" PIPE; NORTH 33.0' AND WEST 35.0' 1/2" ROD, S15W 35.20 IN 10" OAK	N46W 40LKS. F ROCKS W/3" SQUARE ROCK IN B' SPIKE IN 15" OAK, S12E 38.82' SPIKE
B. Description of corner evidence found and/or method applied in restoring or reestablishing corner:  1997 ROWE; FIELD, PS#37276; FND. 3/4" PIPE; RECOVERED 1 PREVIOUS WITNESS WHICH INDICATES THAT FND. PIPE IS IN SAME POSITION AS 1977 CASE SURVEY CITED IN SECTION A. ABOVE; ALSO FND. LARGE STONES BELOW FND. PIPE	
ACCEPTED FND. PIPE AS THE BEST AVAILABLE EVIDENCE OF THE ORIGINAL CO	DRIVER POSITION
C. Description of monument for corner and accessories established to perpetuate locating the properties of the propertie	JONATHAN M. FIELD PROFESSIONAL SURVEYOR No. 17276
Surveyor's Michigan License No. 3/2/6	FORM APPROVED BY MICHIGAN STATE BOARD OF LAND SURVEYORS, JAN. 78, 1871  REVISED MAY 14, 1875 REVISED JAN., 1893  ADAPTED FOR WORD PROCESSING MARCH, 1893
REMONUMENTATION	

NOV 2 6 1997

COMMISSION

26

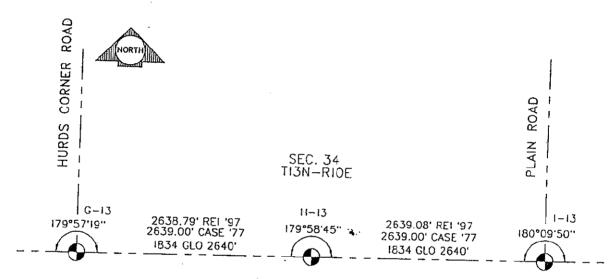

GILFORD ROAD

SEC. 3 TI2N-RI0E