

**1997 REMONUMENTATION PROGRAM  
LAND CORNER RECORDATION CERTIFICATE**  
Filing Requirement of Act 74, Mich. P.A. 1970

RECEIVED FOR RECORD  
LIBER NO. 445 PAGE NO. \_\_\_\_\_  
FILE NO. 445  
ELLINGTON TOWNSHIP  
97 OCT -7 PM 3:03

*Jonathan M. Field*  
TUSCOLA COUNTY  
REGISTERED SURVEYOR

For corners in: ELLINGTON TWP.

<u>TUSCOLA</u> (County)	Located In:	Corner Code #
1. Public Land Survey	T <u>13N</u> R <u>10E</u>	<u>I-13</u>
	T _____ R _____	_____
	T _____ R _____	_____
	T _____ R _____	_____
2. Property Controlling in Section	S _____ T _____ R _____	_____
	S _____ T _____ R _____	_____
3. Miscellaneous Property in Sec.	S _____ T _____ R _____	_____

Register of Deeds Stamp & File Number

4. Lot No. \_\_\_\_\_, Recorded Plat \_\_\_\_\_  
5. Private Claims \_\_\_\_\_

I, JONATHAN M. FIELD, in a field survey on JULY 24 19 97, do hereby certify that under requirements of P.A. 74, Michigan P.A. of 1970, the corner points mentioned in lines 1 and 2 above were in conformance with regulations and rules therefore as required in the current manual of survey instructions of the United States Department of the Interior, Bureau of Land Management or by a decree of a Court of Law and/or that the corner points mentioned in lines 3, 4 and 5 above were in conformance with the rules of the Michigan Board of Land Surveyors or by a Decree of a Court of Law; established, re-established, monumented, re-monumented, recovered, found as expressed below:

	A	B	C	D	E	F	G	H	I	J	K	L	M
1													
2	6	5	4	3	2	1							
3													
4	7	8	9	10	11	12							
5													
6	18	17	16	15	14	13							
7													
8	19	20	21	22	23	24							
9													
10	30	29	28	27	26	25							
11													
12	31	32	33	34	35	36							
13													


NOTE: Not more than 4 corners, all in the same town and range, may be recorded on this certificate.

A. Description of original monument and accessories and/or subsequent restoration:  
1834 GLO; PARKE, D.S.; SET POST; MAPLE 10 N80 1/2E 1.75, ELM 7 N79W .50  
1974 KAY ENG. CO.; KAY, P.S.#14096; SURVEY L.442 PG.720-721; NO OBJECT STATED; S45W 48.98' 12" ELDER, N45W 51.60' 24" MAPLE, N30E 53.35' 24" MAPLE  
1977 CASE SURVEYING; CASE P.S.#15399; SURVEY L.475 PG.338; FND. 5/8" PIN; S25E 23.73' SPIKE IN 12" POST, N40W 50.9' SPIKE IN 28" MAPLE, N30E 52.3' SPIKE IN 30" MAPLE

B. Description of corner evidence found and/or method applied in restoring or reestablishing corner:  
1997 ROWE; FIELD, PS#37276; FND. 1/2" ROD; RECOVERED 2 PREVIOUS WITNESSES WHICH INDICATE THAT FND. ROD IS IN SAME POSITION AS 1974 KAY SURVEY CITED IN SECTION A. ABOVE; ALSO FND. FRAGMENTS OF WOOD BELOW FND. ROD

ACCEPTED FND ROD AS BEST AVAILABLE EVIDENCE OF ORIGINAL CORNER POSITION

C. Description of monument for corner and accessories established to perpetuate locating the position of the corner:  
I-13 REPLACED FND. ROD W/ STD. REMON. MONUMENT STAMPED I 13 T13N R10E  
S74°E, 18.80' FND. 1 1/2" PIPE APPARENT I-1 T12N-R10E  
S65°E, 54.17' SET NAIL W/TAG #37276 IN NE FACE TRIPLE 8" ASH  
S04°W, 19.73' SET CHIS. NOTCH IN W. END 18" CMP  
S48°E, 29.68' FND. 1/2 ROD IN CONC. BAG HEADWALL  
N49°W, 51.77' SET NAIL W/TAG #37276 IN SW FACE 36" MAPLE  
N51°W, 31.02' SET CHIS. NOTCH IN N. END 8" CMP  
N20°E, 54.16' FND. NAIL W/TAG #37276 IN NW FACE 40" MAPLE

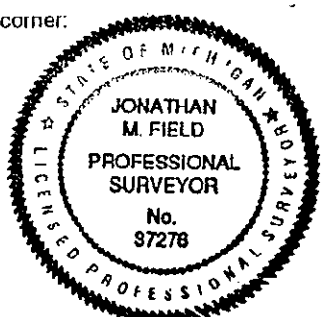

Signed by *Jonathan M. Field* Date 9-24-97  
Surveyor's Michigan License No. 37276

FORM APPROVED BY MICHIGAN STATE BOARD OF LAND SURVEYORS, JAN. 28, 1971  
REVISED MAY 14, 1975  
REVISED JAN., 1983  
ADAPTED FOR WORD PROCESSING MARCH, 1993

APPROVED  
9-22-97  
*[Signature]*

SURVEY &  
REMONUMENTATION

NOV 26 1997

COMMISSION

