

DEC-2-8 2000

SECTION

1994 REMONUMENTATION PROGRAM LAND CORNER RECORDATION CERTIFICATE

Filing Requirement of Act 74, Mich. P.A. 1970

For corners in NOVESTA TOWNSHIP

TUSCOLA (County)	Located In:	Corner Code #
1. Public Land Survey	T13N R11E	M-1
	T R	
	T R	
	T R	
2. Property Controlling in Section	S T R	
	S T R	
3. Miscellaneous Property in Sec.	S T R	
	S T R	

RECEIVED FOR RECORD  
 LIBER NO. PAGE NO  
 FILING NO. #32  
 NOVESTA TWP  
 94 NOV -9 PM 2:17  
 VIRGINIA M. McLAREN  
 TUSCOLA COUNTY  
 REGISTER OF DEEDS  
 Register of Deeds Stamp & File Number

- 4. Lot No. Recorded Plat
- 5. Private Claims

	A	B	C	D	E	F	G	H	I	J	K	L	M
2	6		5		4		3		2		1		
3													
4	7		8		9		10		11		12		
5													
6	18		17		16		15		14		13		
7													
8	19		20		21		22		23		24		
9													
10	30		29		28		27		26		25		
11													
12	31		32		33		34		35		36		
13													

I, Lionel Roy Emery, in a field survey on July 21, 1994, do hereby certify that under requirements of P.A. 74, Michigan P.A. of 1970, the corner points mentioned in lines 1 and 2 above were in conformance with regulations and rules therefore as required in the current manual of survey instructions of the United States Department of the Interior, Bureau of Land Management or by a decree of a Court of Law and/or that the corner points mentioned in lines 3, 4 and 5 above were in conformance with the rules of the Michigan Board of Land Surveyors or by a Decree of a Court of Law; established, re-established, monumented, re-monumented, recovered, found as expressed below:

NOTE: Not more than 4 corners, all in the same town and range, may be recorded on this certificate.

A. Description of original monument and accessories and/or subsequent restoration:

- 1834 (Gov't. Land Office Notes) Harvey Parke, D.S. -Township corner established- Hemlock 12 S59W 11; Beech 10 S79E 25
- 1889 (Resurvey of Evergreen Twp., T13N-R12E, Sanilac County) F.F. Rogers, Surveyor -Set Vitriified Stone 'corner'- 3 inches in diameter and 3 feet in the Earth, set in place of corner established by Gailbraith and checked by me (Rogers). 39.70 chains from West 1/4 corner of Section 7, T13N-R12E.
- 1898 (County Surveyor's Record, pages 312 and 313, Tuscola County) Edward L. Teskey, County Surveyor -Previously set by Rogers Surveyor of Sanilac County- no accessories given.


B. Description of corner evidence found and/or method applied in restoring or reestablishing corner:

Found four stones 4" to 7" dimension in group approximately 26" below surface of Gravel Roads and at centerline intersection of "Greenland" Road North/South with "Elmwood" Road West.

Accepted center stone as marking original corner.

C. Description of monument for corner and accessories established to perpetuate locating the position of the corner:

- Removed stones and replaced with Standard Tuscola County Concrete Monument with 2" Brass Cap stamped M1 T13N/R11E
- N35°E, 62.80' -T.C. Re-mon. tag in Southeast face of pole
- S42°E, 37.09' -T.C. Re-mon. tag in Northeast face of Telephone pole stub
- S64°W, 61.80' -T.C. Re-mon. tag in Southeast face of Power Pole
- N20°W, 138.21' -T.C. Re-mon. tag in Southwest face of Power Pole

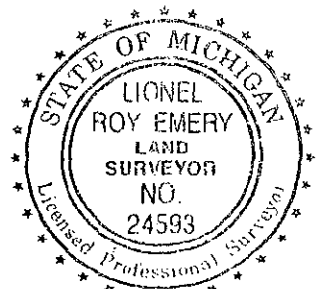

Signed by Lionel Roy Emery

Date Oct. 20, 1994

Surveyor's Michigan License No. 24593

APPROVED  
10-20-94  
*[Signature]*

COPY

