

SURVEY & MONUMENTATION

REC 48 2000

SECTION

COPY

1994 REMONUMENTATION PROGRAM
LAND CORNER RECORDATION CERTIFICATE
Filing Requirement of Act 74, Mich. P.A. 1970

For corners in NOVESTA TOWNSHIP

TUSCOLA (County)	Located In:	Corner Code #
1. Public Land Survey	T 13N R 11E	M-9
	T _____ R _____	
	T _____ R _____	
	T _____ R _____	
2. Property Controlling in Section	S _____ T _____ R _____	
	S _____ T _____ R _____	
3. Miscellaneous Property in Sec.	S _____ T _____ R _____	
	S _____ T _____ R _____	

RECEIVED FOR RECORD
LIBER NO. _____ PAGE NO. _____
FILING NO. # 40
NOVESTA TWP
94 NOV -9 PM 2:18
VIRGINIA M. MCLAREN
TUSCOLA COUNTY
REGISTER OF DEEDS

Register of Deeds Stamp & File Number

4. Lot No. _____ Recorded Plat _____
5. Private Claims _____

	A	B	C	D	E	F	G	H	I	J	K	L	M
2	6	5	4	3	2								
3													
4	7	6	5	4	3	2	1						
5													
6	18	17	16	15	14	13							
7													
8	19	20	21	22	23	24							
9													
10	30	29	28	27	26	25							
11													
12	31	32	33	34	35	36							
13													

I, Lionel Roy Emery, in a field survey on July 18, 1994, do hereby certify that under requirements of P.A. 74, Michigan P.A. of 1970, the corner points mentioned in lines 1 and 2 above were in conformance with regulations and rules therefore as required in the current manual of survey instructions of the United States Department of the Interior, Bureau of Land Management or by a decree of a Court of Law and/or that the corner points mentioned in lines 3, 4 and 5 above were in conformance with the rules of the Michigan Board of Land Surveyors or by a Decree of a Court of Law, established, re-established, monumented, re-monumented, recovered, found as expressed below.

NOTE: Not more than 4 corners, all in the same town and range, may be recorded on this certificate.


- A. Description of original monument and accessories and/or subsequent restoration:
- 1834 (Gov't. Land Office Notes) Harvey Parke, D.S. -Set post corner Secs. 24 & 25- Beech 7 N79W 20; Hemlock 34 S40W 53
 - 1889 (Resurvey of Evergreen Twp., T13N-R12E, Sanilac County) F.F. Rogers, Surveyor -Set Vitrified Stone 'corner' 3 inches in diameter and 3 feet in the Earth- gives no accessories.
 - 1895 (County Surveyor's Record, pages 140 and 141, Sanilac County) M.E. Ward, Surveyor-shows "crock" previously set by F.F. Rogers- gives no accessories.
 - 1972 (Survey -Liber 2, pages 130 and 131, Sanilac County) David T. Rowe, P.S. 11192 -shows S.W. corner of Section 19, T13N-R12E (does not say whether found/set or physical object) S45°E, 82.51' RLS tag in PP; S45°W, 72.31' Nail in PP; S45°W, 43.10' Nail in 6' high TP ---See over for continuation of Section A.---

B. Description of corner evidence found and/or method applied in restoring or reestablishing corner:

Found 'T' Iron and remaining accessories.
Accepted found 'T' Iron as marking original corner.

C. Description of monument for corner and accessories established to perpetuate locating the position of the corner:

Removed 'T' Iron and replaced with Standard Tuscola County Concrete Monument with 2" Brass Cap stamped M9 T13N/R11E
N30°E, 52.94' -T.C. Re-mon. tag in West face of 40" Maple
S45°E, 83.01' -T.C. Re-mon. tag in Southwest face of Power Pole
S45°W, 72.54' -T.C. Re-mon. tag in Northwest face of Power Pole
N28°W, 110.18' -T.C. Re-mon. tag in Northeast face of Power Pole

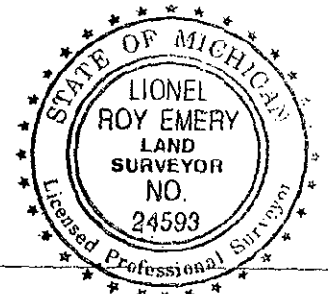

Signed by Lionel Roy Emery Date Oct. 10, 1994
Surveyor's Michigan License No. 24593

APPROVED
10-10-94

1984 (Survey -Liber 4 of Surveys, page 691, Sanilac County) John A. Milletics, P.S. 25859 -Found T Iron- gives no accessories
 1984 (Survey -Liber 4 of Surveys, page 692, Sanilac County) John A. Milletics, P.S. 25859 -shows NW Cor Sec. 30 - gives no object found/set nor accessories.

COPY

