

DEC 28 2000

SECTION

COPY

1994 REMONUMENTATION PROGRAM
LAND CORNER RECORDATION CERTIFICATE
Filing Requirement of Act 74, Mich. P.A. 1970

For corners in NOVESTA TOWNSHIP

<u>TUSCOLA</u> (County)	Located In:	Corner Code #:
1. Public Land Survey	T <u>13N</u> R <u>11E</u>	<u>M-10</u>
	T ___ R ___	_____
	T ___ R ___	_____
	T ___ R ___	_____
2. Property Controlling in Section	S ___ T ___ R ___	_____
	S ___ T ___ R ___	_____
3. Miscellaneous Property in Sec.	S ___ T ___ R ___	_____
	S ___ T ___ R ___	_____
4. Lot No. _____, Recorded Plat _____		
5. Private Claims _____		

RECEIVED FOR RECORD
LIBER NO. _____ PAGE NO. _____
FILING NO. #41
NOVESTA TWP
94 NOV -9 PM 2:18
VIRGINIA M. McLAREN
TUSCOLA COUNTY
REGISTER OF DEEDS

Register of Deeds Stamp & File Number

	A	B	C	D	E	F	G	H	I	J	K	L	M
2	6		5		4		3		2				
3													
4	7		8		9		10		11		12		
5													
6	18		17		16		15		14		13		
7													
8	19		20		21		22		23		24		
9													
10	30		29		28		27		26		25		
11													
12	31		32		33		34		35		36		
13													

I, Lionel Roy Emery, in a field survey on July 18, 1994, do hereby certify that under requirements of P.A. 74, Michigan P.A. of 1970, the corner points mentioned in lines 1 and 2 above were in conformance with regulations and rules therefore as required in the current manual of survey instructions of the United States Department of the Interior, Bureau of Land Management or by a decree of a Court of Law and/or that the corner points mentioned in lines 3, 4 and 5 above were in conformance with the rules of the Michigan Board of Land Surveyors or by a Decree of a Court of Law, established, re-established, monumented, re-monumented, recovered, found as expressed below:

NOTE: Not more than 4 corners, all in the same town and range, may be recorded on this certificate.


- A. Description of original monument and accessories and/or subsequent restoration:
 1834 (Gov't. Land Office Notes) Harvey Parke, D.S. -Set qr. Sec. post- Beech 15 N10W 26½; Hemlock 15 S4W 24
 1889 (Resurvey of Evergreen Twp., T13N-R12E, Sanilac County) F.F. Rogers -Set Vitriified Stone 'corner' 3 inches in diameter and 3 feet in the Earth- gives no accessories.
 1973 (Survey -Liber 430, pages 655 and 656, Tuscola County) David T. Rowe, P.S. 11192 -Set 'T' iron- East, 28.73' Spike in 24" Maple; S45°E, 54.93' Spike in 15" Maple; West, 55.68' Spike in PP
 1975 (Land Corner Recordation Certificate) David T. Rowe, P.S. 11192 -Set 'T' Iron- Accessories same as above Survey
 1984 (Survey -Liber 4 of Surveys, page 691) John A. Milletics, P.S. 25859 --See over for continuation of Sec. A.
- B. Description of corner evidence found and/or method applied in restoring or reestablishing corner:
 Found ½" smooth Iron and remaining accessories.
 Accepted Found iron as marking original corner.

C. Description of monument for corner and accessories established to perpetuate locating the position of the corner:
 Removed found Iron and Replaced with Standard Tuscola County Concrete Monument with 2" Brass Cap stamped M10 T13N/R11E
 S82°E, 28.55' -T.C. Re-mon. tag in South face of 30" Maple
 S45°E, 36.70' -T.C. Re-mon. tag in Southwest face of 28" Maple
 S16°W, 94.31' -T.C. Re-mon. tag in Northwest face of 7" Ash
 West, 56.00' -T.C. Re-mon. tag in North face of Power Pole (also nail in East face of pole)

Signed by Lionel Roy Emery
 Surveyor's Michigan License No. 24593

Date Oct. 10, 1994

APPROVED
10-10-94

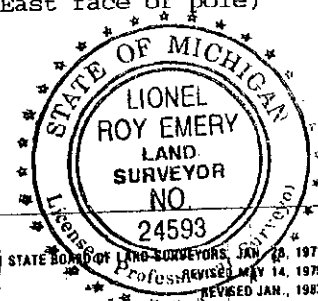

shows 1/2" Iron found, but gives no accessories
1984 (Survey -Liber 4 of Surveys, page 692, Sanilac County) John A. Milletics, P.S. 25859 -show
1/2" Iron found, but gives no accessories

COPY

