

DEC 23 2000

COPY

SECTION

1994 REMONUMENTATION PROGRAM LAND CORNER RECORDATION CERTIFICATE

Filing Requirement of Act 74, Mich. P.A. 1970

For corners in NOVESTA TOWNSHIP

RECEIVED FOR RECORD LIBER NO. PAGE NO. FILING NO. #42 NOVESTA TWP 94 NOV -9 PM 2:18 VIRGINIA M. MCLARCH TUSCOLA COUNTY REGISTER OF DEEDS

Form with fields: TUSCOLA (County), Located In: T 13N R 11E, Corner Code # M-11, 1. Public Land Survey, 2. Property Controlling in Section, 3. Miscellaneous Property in Sec., 4. Lot No., Recorded Plat, 5. Private Claims

Register of Deeds Stamp & File Number

Grid table with columns A-M and rows 2-13, containing numbers 1-36.


I, Lionel Roy Emery, in a field survey on July 18, 1994, do hereby certify that under requirements of P.A. 74, Michigan P.A. of 1970, the corner points mentioned in lines 1 and 2 above were in conformance with regulations and rules therefore as required in the current manual of survey instructions of the United States Department of the Interior, Bureau of Land Management or by a decree of a Court of Law and/or that the corner points mentioned in lines 3, 4 and 5 above were in conformance with the rules of the Michigan Board of Land Surveyors or by a Decree of a Court of Law: established, re-established, monumented, re-monumented, recovered, found as expressed below:

NOTE: Not more than 4 corners, all in the same town and range, may be recorded on this certificate.

- A. Description of original monument and accessories and/or subsequent restoration: 1834 (Gov't. Land Office Notes) Harvey Parke, D.S. -Set post corner Secs. 25 & 36- Cedar 7 N17W 18; B. Ash 9 S81 1/2 W 3 1/2 1889 (Resurvey of Evergreen Twp., T13N-R12E, Sanilac County) F.F. Rogers -Set Vitrified Stone 'corner' 3 inches in diameter and 3 feet in the Earth- gives no accessories 1974 (Survey -Liber 3 of Surveys, pages 116 and 117, Sanilac County) Irvin E. Choep, P.S. 6504 ** Shows N.W. cor. Sec. 31 T.13N.-R.12E.--No accessories given. 1980 (Survey -Liber 509, page 569, Tuscola County) Stewart G. Case, P.S. #15399 1/4" steel pin in mon. box in place. Nail SE side T.P., S30°W-77.0'; Nail NE side T.P., N50°W-44.75'; N. cor. proj. marker post, S60°W-41.95' 1983 (Survey -Liber 539, page 1530, Tuscola County) Jan S. Fokens, P.S. 21667 ---See over for continuation of A. B. Description of corner evidence found and/or method applied in restoring or reestablishing corner: Found 1/2" diameter rod in Monument Box together with accessories from Surveys by Case and Fokens.

Accepted found iron as marking original corner.

- C. Description of monument for corner and accessories established to perpetuate locating the position of the corner: Removed 1/2" rod from Monument Box and Replaced with 5/8" Reinforcing rod with 2" Brass Cap stamped M11 T13N-R11E attached to reinforcing rod. Placed Concrete around Reinforcing rod. S35°E, 28.56' -Set 1/2" diameter Reinforcing rod S24°W, 77.00' -T.C. Re-mon. tag above found nail in East face of Telephone Pole S53°W, 42.08' -Center of exposed 3/4" iron in top of Triangular Concrete marker N42°W, 44.73' -T.C. Re-mon. tag above found nail in Northeast face of Telephone Pole

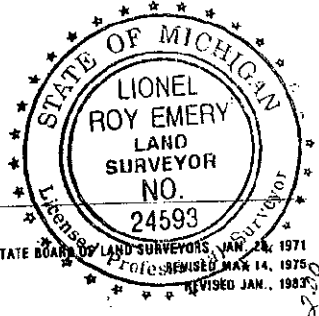

Signed by Lionel Roy Emery Date Oct. 10, 1994 Surveyor's Michigan License No. 24593

APPROVED 10-10-94 [Signature]

Marker and accessories same as shown on Case Survey.

**
1975 (Land Corner Recordation Certificate) David T. Rowe, P.S. 11192 -Found 3/8" rod- N25°W 104' spike in PP; N45°W 44.73' spike in TP; S25°W 76.96' spike in TP

COPY

