


GOVERNMENT SURVEY CORNER NUMBERING CODE DIAGRAM

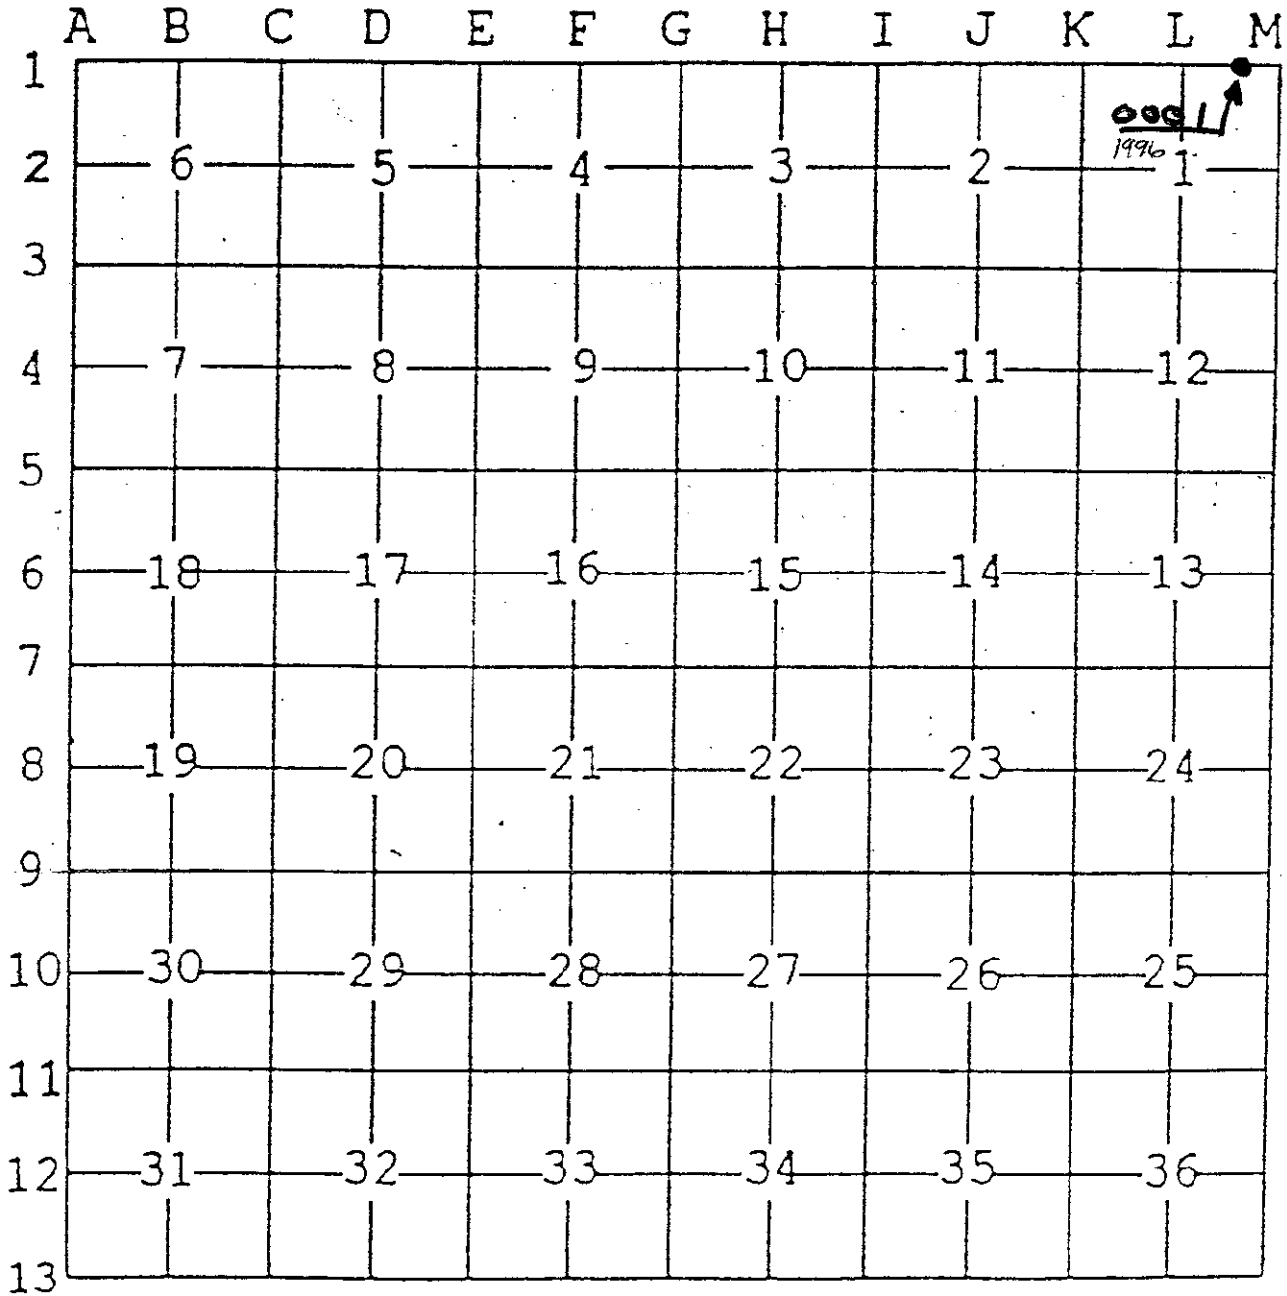

1996
1

SURVEY &
REMONUMENTATION

FEB 28 1997

COMMISSION

Wisner Twp.

T 14 N - R 7 E