
## 1996 REMONUMENTATION PROGRAM LAND CORNER RECORDATION CERTIFICATE

For corners in WISNE	Filing Requi	rement of Act 74, Mich. P.A.	1970			~		37.6	
TUSCOLA (County)	Located in:	Corner Code #			PEOIST	1. 1. 1. 1. 1. 1. 1. 1. 1. 1. 1. 1. 1. 1	35 DEC ;	NO L	ECEIVE
1. Public Land Survey	T_14N_R_07E_ TR TR	F-13			A A COUNT	Sec.	26 AHII: 4	Janer Janer	D FOR RECOR
in Section	TR STR				) <sub>S</sub> <	5	61:	ton!	208.D 24.00
<ol> <li>Miscellaneous Property in Sec.</li> </ol>	STR STR		Regis	ter of I	Deeds	Stamp	& File	Numb	er
4. Lot No,	Recorded Plat								
5. Private Claims	issorded i lat		- ,	A B	C D	E F	е н	t J ;	<b>( 1</b>
			. 2	1	5		]	1	T
I Tosta messa.			,	1 0		4	3	2	
do hereby certify that under	, in a field survey on MA	NY 21 19 96	. 4	7	8	9	10	11	Ι,
in lines 1 and 2 above wer	a in conformance with whichigan p	A. of 1970, the corner points mentioned	d 5	<b> </b>		<u> </u>		<u>  '                                   </u>	12
Management or by a decree	of a Court of Level	inment of the Interior, Bureau of Land	, ,	18	17	16	15	14	K
above were in conformance	with the other of the American trial trial Co.	mer points mentioned in lines 3, 4, and	5 7	<u> </u>	<del> </del> -	ļ			
expressed below:	, re-established, monumented, n	d of Land Surveyors or by a Decree of e-monumented, recovered, found as		19	20	21	22	23	24
		•	, à 10	20			<del> </del> -		
NOTE: Not more than 4 corners, all in the same town and range, may be recorded on this certificate.			11	.30	29	28	27	26	25
			12	31	32	33	34	35	36
3. Description of corpo									
C/L GRAVEL RO	DAD TO N .: DID NOT ACC	d applied in restoring or reestablish T-IRON 10.4' S. OF C/L EPT T-IRON BUT HELD AS F BY SINGLE PROPORTION BET	ASPH.	ROA	D E-W ONTRO & G-	% 10 DLLING	0' E. 3 COR 14N-R	OF NER; 7E	
ACCEPTED SINGLE PR	OPORTION AS PROPER REP	establishment of origina	L COR	NER 1	LOCAT	ION			
Description of monun F-13 SET STANDARD S64°E, 13.83	nent for corner and accessories REMON MONUMENT STAMPED FND. T-IRON	established to perpetuate locating "F 13 T14N R7E" IN MON			of the	corner	:		
N49°W, 58.02	SET 1/2" ROD W/CAP #	37276			(بي		0000	; L	-
N45°E, 6.82	CENTER OF ROAD SIGN SET 1/2" ROD W/CAP #	POST			Treated.	المديدة عصوات الم على الم	TILL H	1	
N21 E, 66.90	FND. P-K NATT IN NW	F300 D D0+-		. 1	5	JONAT		(*, <b>\</b>	,
577°W, 39.93°	SET 1/2" ROD W/CAP #:	37276		***************************************	~ f _	M. FII ROFES: SURVE No. 3727	SIONAL YOR	SURVEYOR'	
gned by Anth	m 1:00	,	<u> </u>	•	***	0	104	-	
urveyar's Michigan License	No. 37276	Date	PG ROVED BY IV	NADIHOIN S	TATE BOAT	D OF LAND	SUBVENE		- · •
Later Profession 1985 II Robbins Rock	AP /2	PROVED 186.		- ··· <b>v</b>			REVISE	D MAY 14,	1975

May 2 º 1307

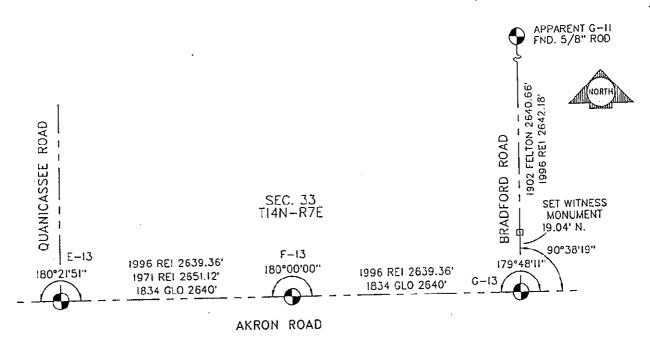

SEC. 4 TI3N-R7E