

**1996 REMONUMENTATION PROGRAM
LAND CORNER RECORDATION CERTIFICATE**
Filing Requirement of Act 74, Mich. P.A. 1970

For corners in WISNER TWP.
TUSCOLA
(County)

Located In: _____ Corner Code # _____

- | | | |
|---------------------------------------|---------------------------|-------------|
| 1. Public Land Survey | T <u>14N</u> R <u>07E</u> | <u>H-13</u> |
| | T _____ R _____ | _____ |
| | T _____ R _____ | _____ |
| | T _____ R _____ | _____ |
| 2. Property Controlling in Section | S _____ T _____ R _____ | _____ |
| | S _____ T _____ R _____ | _____ |
| 3. Miscellaneous Property in Sec. | S _____ T _____ R _____ | _____ |
| | S _____ T _____ R _____ | _____ |
| 4. Lot No. _____, Recorded Plat _____ | | |
| 5. Private Claims _____ | | |

RECEIVED FOR RECORD
LIBER NO. _____ PAGE NO. 29
FILE NO. WISNER TWP.
96 DEC 30 PM 1:59
Jonathan M. Field
TUSCOLA COUNTY
REGISTER OF DEEDS

Register of Deeds Stamp & File Number

1	A	B	C	D	E	F	G	H	I	J	K	L	M
2	6	5	4	3	2	1							
3													
4	7	8	9	10	11	12							
5													
6	18	17	16	15	14	13							
7													
8	19	20	21	22	23	24							
9													
10	30	29	28	27	26	25							
11													
12	31	32	33	34	35	36							
13													

I, JONATHAN M. FIELD, in a field survey on MAY 21 19 96, do hereby certify that under requirements of P.A. 74, Michigan P.A. of 1970, the corner points mentioned in lines 1 and 2 above were in conformance with regulations and rules therefore as required in the current manual of survey instructions of the United States Department of the Interior, Bureau of Land Management or by a decree of a Court of Law and/or that the corner points mentioned in lines 3, 4 and 5 above were in conformance with the rules of the Michigan Board of Land Surveyors or by a Decree of a Court of Law; established, re-established, monumented, re-monumented, recovered, found as expressed below:


NOTE: Not more than 4 corners, all in the same town and range, may be recorded on this certificate.

- A. Description of original monument and accessories and/or subsequent restoration:
1834 GLO; RISDON, D.S.; SET POST; TAMARACK 12 N58E 31LKS, B. ASH 12 N20W 36LKS
1902 FELTON, C.S.; SURVEY OF SEC.34, T14N-R7E SET FROM MEAS; CEDAR POST AND CROCKERY; NO WITS
* 1974 WITNESS CARD AT ROWE ENG.; SET ROD & CAP AT GOVT. DIST FROM N1/4 COR. SEC.3; EAST 32.34' N1/4 COR SEC 3 T13N-R7E, NORTH 4.5' C/L PAVT, N45E 34.55' ROAD SIGN POST, N45W 52.25' EAST EDGE STOP SIGN POST
1992 ROWE ENG., FIELD P.S.#37276; LCRC PG.22; FND ROD W/ CAP; NORTH 4.8' C/L AKRON RD., N45E 34.58' CENTER RD SIGN POST, N40W, 49.35' STOP SIGN POST, S45W, 13.90' E. LEG SIGN POST
* 1917 BRUMLEY; MINUTES OF SURVEY NORTHWEST DRAIN OUTLET #2; C/L DRAIN 0.42 CH. S. OF CORNER

- B. Description of corner evidence found and/or method applied in restoring or reestablishing corner:
1996 ROWE ENG.; FIELD, P.S.#37276; FND. 1/2" ROD W/CAP 4.8' S. OF C/L ASPH. ROAD E-W & 7.5' E. OF C/L GRAVEL ROAD TO N. DID NOT ACCEPT FND. ROD BUT HELD AS PROPERTY CONTROLLING CORNER; REESTABLISHED POSITION FOR CORNER BY SINGLE PROPORTION BETWEEN G-13 & I-13 T14N-R7E
SET REFERENCE MONUMENT 16.98' N. OF H-13 DUE TO DITCH
POSITION FITS 1917 CALL TO C/L OF DRAIN W/IN 2-4'
ACCEPTED SINGLE PROPORTION AS PROPER REESTABLISHMENT OF ORIGINAL CORNER POSITION

- C. Description of monument for corner and accessories established to perpetuate locating the position of the corner:
H-13 SET REFERENCE REMONUMENT STAMPED "H 13 T14N R7E"
S87°E, 10.89' FND. 1/2" ROD
EAST, 43.12' FND. 1/2" ROD
NORTH, 83.02' SET 1/2" ROD W/CAP #37276
N59°W, 34.31' SET 1/2" ROD W/CAP #37276
N56°E, 43.15' SET 1/2" ROD W/CAP #37276
S73°E, 24.61' SET 1/2" ROD W/CAP #37276
N18°E, 131.41' SET P-K NAIL W/TAG #37276 IN SE FACE P.POLE

Signed by Jonathan M. Field Date 12-24-96
Surveyor's Michigan License No. 37276

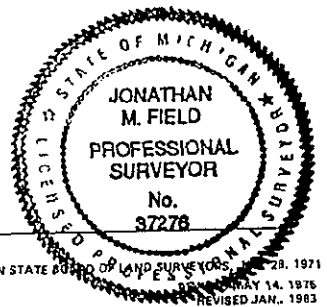

APPROVED
12-23-96
[Signature]

FORM APPROVED BY MICHIGAN STATE BOARD OF LAND SURVEYORS MAY 14, 1976
REVISED JAN., 1983
ADAPTED FOR WORD PROCESSING MARCH, 1993

MAY 20 1997

11
N/A

