

**1996 REMONUMENTATION PROGRAM
LAND CORNER RECORDATION CERTIFICATE**

Filing Requirement of Act 74, Mich. P.A. 1970

For corners in WISNER TWP.

TUSCOLA Located In: _____ Corner Code # _____
(County)

1. Public Land Survey T 14N R 07E _____ I-13 _____
T _____ R _____ _____
T _____ R _____ _____
T _____ R _____ _____

2. Property Controlling S _____ T _____ R _____
in Section S _____ T _____ R _____
3. Miscellaneous S _____ T _____ R _____
Property in Sec. S _____ T _____ R _____

4. Lot No. _____, Recorded Plat _____
5. Private Claims _____

I, JONATHAN M. FIELD, in a field survey on MAY 21 19 96, do hereby certify that under requirements of P.A. 74, Michigan P.A. of 1970, the corner points mentioned in lines 1 and 2 above were in conformance with regulations and rules therefore as required in the current manual of survey instructions of the United States Department of the Interior, Bureau of Land Management or by a decree of a Court of Law and/or that the corner points mentioned in lines 3, 4 and 5 above were in conformance with the rules of the Michigan Board of Land Surveyors or by a Decree of a Court of Law; established, re-established, monumented, re-monumented, recovered, found as expressed below:

NOTE: Not more than 4 corners, all in the same town and range, may be recorded on this certificate.


- A. Description of original monument and accessories and/or subsequent restoration:
1834 GLO RISDON, D.S.; SET POST; B. ASH 14 N70W 33LKS, SWAMP W. OAK 9 N80E 6LKS
1902 FELTON C.S.; SURVEY OF SEC. 34, T14N-R7E; PREV. SET CEDAR POST CROCKERY AND STONE; NO WITNESSES GIVEN
- * 1972 WITNESS CARD AT ROWE ENG.; FND. P-K NAIL REPLACED W/MON. SPIKE; N15W 47.02' RLS 11192 TAG IN P/P, EAST 23.80' NW COR SEC 2 T13N-R7E, N70E 59.25' RD SIGN POST, S10W 87.27' RLS 11192 TAG IN GUY POLE
- * 1917 BRUMLEY; MINUTES OF SURVEY NORTHWEST DRAIN OUTLET #2; C/L DRAIN 0.42 CH. S. OF CORNER

GLO NOTES FOR T13N-R7E INDICATE THAT THIS CORNER IS NOT COMMON WITH I-1 T13N-R7E

- B. Description of corner evidence found and/or method applied in restoring or reestablishing corner:
1996 ROWE ENG.; FIELD, P.S.#37276; FND. MON. SPIKE - DID NOT ACCEPT BUT HELD AS PROPERTY CONTROLLING CORNER; REESTABLISHED POSITION FOR CORNER BY PRORATION TO 1902 FELTON SURVEY USING DIST. FROM I-12 TO I-11 T14N-R7E AND HOLDING LINE FROM I-12 THROUGH FND. MON. SPIKE - SET WITNESS MONUMENT ON LINE I-13 TO I-12 T14N-R7E 14.93' N. OF I-13
POSITION FITS 1917 CALL TO C/L DRAIN W/IN 2-4'
ACCEPTED PROPORTION TO 1902 CO. SURVEY AS PROPER REESTABLISHMENT OF ORIGINAL CORNER POSITION

- C. Description of monument for corner and accessories established to perpetuate locating the position of the corner:
I-13 SET WITNESS MONUMENT (STANDARD REMON MONUMENT STAMPED "W.C. I 13 T14N R7E" IN MON. BOX WITNESSES ARE TO WITNESS MONUMENT NOT CORNER I-13 (WITNESS CORNER)
EAST, 23.93' FND. 1/2" PIPE IN MON. BOX
N45°E, 54.74' SET P-K NAIL W/TAG #37276 IN SE FACE WOOD POST
S10°E, 24.19' SET P-K NAIL W/TAG #37276 IN TOP OF GUARD RAIL POST
S75°W, 40.38' SET P-K NAIL W/TAG #37276 IN TOP OF GUARD RAIL POST
N50°W, 38.03' SET 1/2" ROD W/CAP #37276

Signed by Jonathan M. Field Date 12-24-96
Surveyor's Michigan License No. 37276

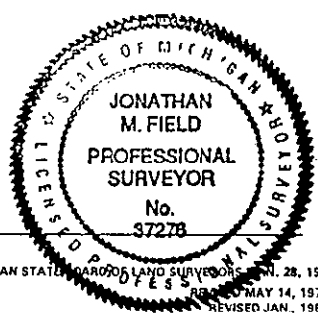

FORM APPROVED BY MICHIGAN STATE BOARD OF LAND SURVEYORS, JAN. 28, 1971
REVISED MAY 14, 1976
REVISED JAN. 1983
ADAPTED FOR WORD PROCESSING MARCH, 1993

APPROVED
12-23-96
1500 RRB J.M.E.

RECEIVED FOR RECORD
LIBER NO. _____ PAGE NO. 42
FILE NO. Wisner Twp.
Jonathan M. Field
96 DEC 26 AM 11:49
TUSCOLA COUNTY
REGISTER OF DEEDS
Register of Deeds Stamp & File Number

	A	B	C	D	E	F	G	H	I	J	K	L	M
1													
2	6	5	4	3	2	1							
3													
4	7	8	9	10	11	12							
5													
6	18	17	16	15	14	13							
7													
8	19	20	21	22	23	24							
9													
10	30	29	28	27	26	25							
11													
12	31	32	33	34	35	36							
13													

MAY 20 1997

