
1996 REMONUMENTATION PROGRAM LAND CORNER RECORDATION CERTIFICATE

LAND CORNER RECORDATION CERTIFICATE										
For corners in WISNER	ch. P.A. 1970		SOL SOL		96 DEC	TER 119.	RECEL			
TUSCOLA (County)	Loc	ated in:	Corner Code #			1001A 11001A		26	DIS'	CELVED FOR
1. Public Land Survey	T T	4N R 07E R R	J-13			SGSTG	(E) 22 S	64 : II MJ	DCC TA	, песовр
2. Property Controlling	. s t			•				•	1015	il
in Section 3. Miscellaneous		R		Regist	er of D	eeds S	tamp 8	k File N	Numbe	г
Property in Sec.		R R		· [:						
4 Lat No	D									
4. Lot No, 5. Private Claims	necorded Plat				A B	C D	E F 6	3 H I	JK	L M
		3.0.0		2	6	5	4	3	Ż	1
			•	3 19 96 4	-	<u> </u>				
I, JONATHAN M. FIELD , in a field survey on MAY 21 19 96, do hereby certify that under requirements of P.A. 74, Michigan P.A. of 1970, the corner points mentioned in lines 1 and 2 above were in conformance with regulations and rules therefore as required in the current manual of survey instructions of the United States Department of the Interior, Bureau of Land Management or by a decree of a Court of Law and/or that the corner points mentioned in lines 3, 4 and 5 above were in conformance with the rules of the Michigan Board of Land Surveyors or by a Decree of a						8	9	10	11	12
						17	16	15	14	13
above were in conformance Court of Law; establishe expressed below:	with the rules d, re-establish	of the Michigan Board ed, monumented, re	d of Land Surveyors or by e-monumented, recovered	a Decree of a g i, found as 9	19	20	21	22	23	24
NOTE: Not more than 4 corners, all in the same town and range, may be recorded					30	29	28	27	26	25
on this certificate.				raea 11 12 13	31	32	33	34	35	36
DIVISION LI	FIELD, P.S NE N-S; RE	.#37276; FND.	VIOUS WITNESSES	C/L ASPH. F	OAD E	I-W & IAT FI	ON F	IELD - IROI	1 IS	IN
ACCEPTED FND. T-	IRON AS BE	ST EVIDENCE O	F ORIGINAL CORNE	R POSITION						
NORTH, 47.5 \$20°E, 62.7 N75°W, 30.1	RON, SET S 54' FND. N 73' W. CORI .7' SET 1/2	TANDARD REMON	192 IN S. FACE P GWALL #37276	D "J 13 T14N	oositior R7E"	of the IN 1	JON	BOX MICONO ATHAN	Contract to the second	
Signed by Austra Surveyor's Michigan Lice	195 Find nse No. <u>372</u>	76	APPROVED /	2-16-96 MPDAM APPROVED B	Y МІСНІДАК	ADAPTE	PROFE SUR	SSION, VEYOR Io. 278 S S kell	AL STATE OF THE SENSE MARC	26, 1971 4, 1975 4, 1983 H, 1993

MAY 2 0 1097


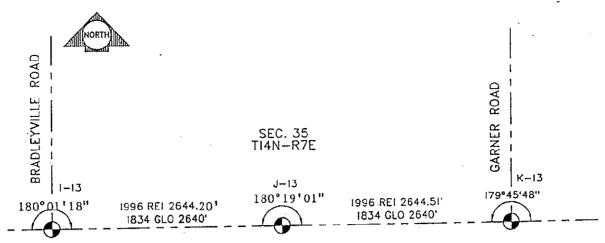

AKRON ROAD

SEC. 2 TI3N-R7E