

**1996 REMONUMENTATION PROGRAM
LAND CORNER RECORDATION CERTIFICATE**
Filing Requirement of Act 74, Mich. P.A. 1970

RECEIVED FOR RECORD
LIBER NO. _____ PAGE NO. 29
FILE NO. Wisner

95 DEC 10 AM 9:00

For corners in **WISNER TWP.**

TUSCOLA Located In: _____ Corner Code # _____
(County)

- | | | |
|------------------------------------|--------------------------|------------|
| 1. Public Land Survey | T <u>14N</u> R <u>7E</u> | <u>M-8</u> |
| | T _____ R _____ | _____ |
| | T <u>14N</u> R <u>8E</u> | <u>A-8</u> |
| | T _____ R _____ | _____ |
| 2. Property Controlling in Section | S _____ T _____ R _____ | _____ |
| | S _____ T _____ R _____ | _____ |
| 3. Miscellaneous Property in Sec. | S _____ T _____ R _____ | _____ |
| | S _____ T _____ R _____ | _____ |

George M. Wisner
TUSCOLA COUNTY
REGISTER OF DEEDS

Register of Deeds Stamp & File Number

4. Lot No. _____, Recorded Plat _____
5. Private Claims _____

	A	B	C	D	E	F	G	H	I	J	K	L	M
1													
2	6	5	4	3	2	1							
3													
4	7	8	9	10	11	12							
5													
6	18	17	16	15	14	13							
7													
8	19	20	21	22	23	24							
9													
10	30	29	28	27	26	25							
11													
12	31	32	33	34	35	36							
13													

I, JONATHAN M. FIELD, in a field survey on MAY 21 1996, do hereby certify that under requirements of P.A. 74, Michigan P.A. of 1970, the corner points mentioned in lines 1 and 2 above were in conformance with regulations and rules therefore as required in the current manual of survey instructions of the United States Department of the Interior, Bureau of Land Management or by a decree of a Court of Law and/or that the corner points mentioned in lines 3, 4 and 5 above were in conformance with the rules of the Michigan Board of Land Surveyors or by a Decree of a Court of Law; established, re-established, monumented, re-monumented, recovered, found as expressed below:

NOTE: Not more than 4 corners, all in the same town and range, may be recorded on this certificate.

- A. Description of original monument and accessories and/or subsequent restoration:
 1834 GLO; RISDON, D.S.; SET POST; B. ASH 10 S43W 19LKS, B. ASH 9 N30W 25LKS
 1902 FELTON, C.S.; PREV SET CEDAR POST; NO WITS GIVEN
 1981 FOLKENS, P.S.#21567; LCRC PG.14; SET 1/2" ROD BY SINGLE PROP. MEAS; S85W 64.39' NAIL W/TAG IN P/P, S87W 37.10' NAIL W/ REI TAG IN 26" STUMP, WEST 12.90' C/L VASSAR RD, EAST 25'± C/L DRAIN
 1984 ROWE ENG.; FOLKENS, P.S.#21567; SURVEY L.542, PG.371; FND. ROD W/REI CAP; SAME WITS AS 1981 LCRC ABOVE EXCEPT S85W 64.89' TO P.POLE


- B. Description of corner evidence found and/or method applied in restoring or reestablishing corner:
 1996 ROWE ENG.; FIELD, P.S.#37276; FND. NO EVIDENCE OF MONUMENT AT CORNER; REESTABLISHED POSITION OF CORNER BY SINGLE PROPORTION BETWEEN M-7 & M-9 T13N-R7E; POSITION THUS ESTABLISHED FALLS ON FIELD DIVISION LINE E&W AND 17.5' E. OF C/L ASPH. ROAD N-S

ACCEPTED SINGLE PROPORTION POSITION AS PROPER REESTABLISHMENT OF ORIGINAL CORNER POSITION.

- C. Description of monument for corner and accessories established to perpetuate locating the position of the corner:
 M-8 SET STANDARD REMONUMENT STAMPED "M 8 T14N R7E" IN MON. BOX
 N79°W, 29.29' SET 1/2" ROD W/CAP #37276
 S79°W, 59.09' SET NAIL W/REMON TAG IN S. FACE P.POLE
 S47°W, 45.26' SET 1/2" ROD W/CAP #37276
 S03°W, 35.63' SET 1/2" ROD W/CAP #37276

NOTE: THIS CORNER IS COMMON WITH A-8 T14N-R8E

Signed by Jonathan M. Field Date 11-29-96
 Surveyor's Michigan License No. 37276

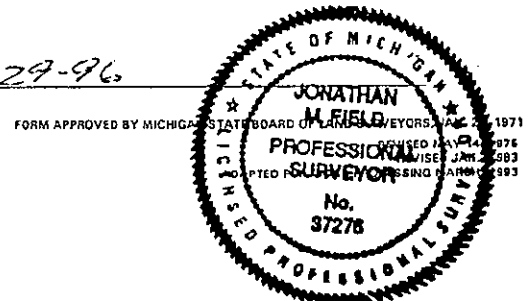

APPROVED
11-27-96
RWB
L.P.C.

REMONUMENTATION
MAY 29 1997

