

**1996 REMONUMENTATION PROGRAM  
LAND CORNER RECORDATION CERTIFICATE**  
Filing Requirement of Act 74, Mich. P.A. 1970

RECEIVED FOR RECORD  
LIBER NO. \_\_\_\_\_ PAGE NO. 26  
FILE NO. Wisner

96 DEC 10 AM 9:00

For corners in **WISNER TWP.**

TUSCOLA Located In: \_\_\_\_\_ Corner Code # \_\_\_\_\_  
(County)

1. Public Land Survey T 14N R 7E \_\_\_\_\_  
T \_\_\_\_\_ R \_\_\_\_\_  
T 14N R 8E \_\_\_\_\_  
T \_\_\_\_\_ R \_\_\_\_\_
2. Property Controlling S \_\_\_\_\_ T \_\_\_\_\_ R \_\_\_\_\_  
in Section S \_\_\_\_\_ T \_\_\_\_\_ R \_\_\_\_\_
3. Miscellaneous S \_\_\_\_\_ T \_\_\_\_\_ R \_\_\_\_\_  
Property in Sec. S \_\_\_\_\_ T \_\_\_\_\_ R \_\_\_\_\_

M-11  
\_\_\_\_\_  
A-11  
\_\_\_\_\_  
\_\_\_\_\_  
\_\_\_\_\_

*Jonathan M. Field*  
TUSCOLA COUNTY  
REGISTER OF DEEDS

Register of Deeds Stamp & File Number

4. Lot No. \_\_\_\_\_, Recorded Plat \_\_\_\_\_  
5. Private Claims \_\_\_\_\_

I, JONATHAN M. FIELD, in a field survey on MAY 21 19 96.

do hereby certify that under requirements of P.A. 74, Michigan P.A. of 1970, the corner points mentioned in lines 1 and 2 above were in conformance with regulations and rules therefore as required in the current manual of survey instructions of the United States Department of the Interior, Bureau of Land Management or by a decree of a Court of Law and/or that the corner points mentioned in lines 3, 4 and 5 above were in conformance with the rules of the Michigan Board of Land Surveyors or by a Decree of a Court of Law; established, re-established, monumented, re-monumented, recovered, found as expressed below:

NOTE: Not more than 4 corners, all in the same town and range, may be recorded on this certificate.

	A	B	C	D	E	F	G	H	I	J	K	L	M
1													
2	6	5	4	3	2	1							
3													
4	7	8	9	10	11	12							
5													
6	18	17	16	15	14	13							
7													
8	19	20	21	22	23	24							
9													
10	30	29	28	27	26	25							
11													
12	31	32	33	34	35	36							
13													

- A. Description of original monument and accessories and/or subsequent restoration:  
1834 GLO; RISDON, D.S.; SET POST; TAMK 8 N38W 25LKS, W. ASH 10 S44E 20LKS  
1974 LEACH, P.S.#7236; LCRC PG.14; SET R.R. SPIKE; N45E 15.55' NW COR BRIDGE DECK, S45E 22.25' SW COR BRIDGE DECK, WEST 15.80' C/L ROAD  
1976 LEACH ENG.; TOMMER, P.S.#22444; SURVEY L.465, PG.192; R.R. SPIKE; SAME WITS AS 1974 LCRC  
1978 GRAVLIN, P.S.#23510; SURVEY L.490, PG.248; NO OBJECT STATED; SAME WITS AS 1974 LCRC ABOVE  
1985 DUNTON, P.S.#23503; SURVEY L.553, PG.488; FND SPIKE AND TAG; SAME WITS AS 1974 LCRC ABOVE  
1985 DUNTON, P.S.#23503; SURVEY L.567, PG.577; FND SPIKE AND TAG; SAME WITS AS 1974 LCRC ABOVE  
1987 WADE-TRIM; MCGINNIS, P.S.#18999; SURVEY L.584, PG.465; FND IRON; E. 11.5' W. EDGE OF BRIDGE DECK, N. 22.0' NW COR. WINGWALL, W. 15' C/L ROAD  
1987 DE LA MATER, P.S.#13030; LCRC PG.16; FND. 5/8" BAR W/CAP; CTR BELL RISER N40W 60.80', S. 88.92' P/P W/NAIL, W. 14.16' PK C/L ROAD

GLO NOTES FOR T14N-R8E INDICATE THAT THIS CORNER IS COMMON WITH A-11 T14N-R8E

- B. Description of corner evidence found and/or method applied in restoring or reestablishing corner:  
1996 ROWE ENG.; FIELD, P.S.#37276; FND. 2 1/2" PIPE IN MON BOX 8.5' N. OF C/L ASPH. ROAD TO W., 3.5' N. OF C/L ASPH. ROAD TO E., AND 17.2' E. OF C/L ASPH. ROAD N-S; RECOVERED 2 PREVIOUS WITNESSES WHICH INDICATE THAT FND. PIPE IS IN SAME POSITION AS 1974 LCRC ABOVE

1990± T.C.R.C. C/L ROAD WAS RELOCATED W'LY OF OLD C/L DURING RECONSTRUCTION

ACCEPTED FND. 2 1/2" PIPE IN MON. BOX AS BEST EVIDENCE OF ORIGINAL CORNER POSITION

- C. Description of monument for corner and accessories established to perpetuate locating the position of the corner:  
M-11 SET 5/8" ROD W/ STANDARD REMON CAP STAMPED "M 11 T14N R7E" INSIDE FND. PIPE ENCASED BOTH IN CONC. IN MON. BOX


- N02°E, 22.94' SET CHIS "+" NLY COR. OF NW WINGWALL
- S02°E, 31.32' SET CHIS "+" SLY COR. OF W. WINGWALL
- N40°E, 15.57' NW COR. CONC. BRIDGE DECK
- S35°E, 22.36' W. COR. CONC. BRIDGE DECK
- S40°W, 88.95' FND. NAIL W/FLAG. IN NW FACE P. POLE
- EAST, 11.43' W. EDGE OF CONC. BRIDGE DECK

Signed by Jonathan M. Field Date 11-29-96  
Surveyor's Michigan License No. 37276

APPROVED  
11-27-96

*J.M.F.*  
*11/27/96*

FORM APPROVED BY MICHIGAN STATE BOARD OF LAND SURVEYORS, JAN. 1976

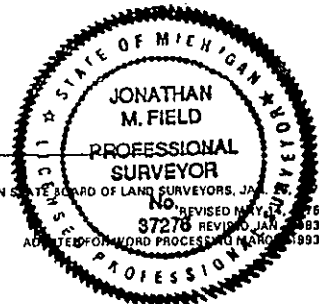

MAY 20 1997

26

