

**1996 REMONUMENTATION PROGRAM
LAND CORNER RECORDATION CERTIFICATE**
Filing Requirement of Act 74, Mich. P.A. 1970

RECEIVED FOR RECORD
LIBER NO. _____ PAGE NO. 92
FILE NO. S. AKRON

96 DEC 10 AM 8:59

For corners in S. AKRON TWP.

<u>TUSCOLA</u>	Located In:	Corner Code #
(County)		
1. Public Land Survey	T <u>14N</u> R <u>08E</u>	<u>A-1</u> ✓
	T <u>14N</u> R <u>7E</u>	<u>M-1</u>
	T <u>15N</u> R <u>7E</u>	<u>M-13</u>
	T <u>15N</u> R <u>8E</u>	<u>A-13</u>
2. Property Controlling	S _____ T _____ R _____	_____
in Section	S _____ T _____ R _____	_____
3. Miscellaneous	S _____ T _____ R _____	_____
Property in Sec.	S _____ T _____ R _____	_____
4. Lot No. _____, Recorded Plat _____		
5. Private Claims _____		

Jonathan M. Field
TUSCOLA COUNTY
REGISTER OF DEEDS

Register of Deeds Stamp & File Number

I, JONATHAN M. FIELD, in a field survey on MAY 21 19 96, do hereby certify that under requirements of P.A. 74, Michigan P.A. of 1970, the corner points mentioned in lines 1 and 2 above were in conformance with regulations and rules therefore as required in the current manual of survey instructions of the United States Department of the Interior, Bureau of Land Management or by a decree of a Court of Law and/or that the corner points mentioned in lines 3, 4 and 5 above were in conformance with the rules of the Michigan Board of Land Surveyors or by a Decree of a Court of Law; established, re-established, monumented, re-monumented, recovered, found as expressed below:

	A	B	C	D	E	F	G	H	I	J	K	L	M
1													
2	6	5	4	3	2	1							
3													
4	7	8	9	10	11	12							
5													
6	18	17	16	15	14	13							
7													
8	19	20	21	22	23	24							
9													
10	30	29	28	27	26	25							
11													
12	31	32	33	34	35	36							
13													

NOTE: Not more than 4 corners, all in the same town and range, may be recorded on this certificate.

A. Description of original monument and accessories and/or subsequent restoration:

- 1834 GLO; RISDON, D.S.; SET AS M-1 OF THE ORIGINAL GOVERNMENT SURVEY OF T14N-R7E; POST; W. OAK 14 S60 1/2W 6.77CH, B. OAK 12 N29W 6.88CH.
- 1902 FELTON, C.S.; SURVEY IN SE1/4 SEC.1; PREV SET CEDAR POST AND CROCKERY; NW COR BRIDGE S34 1/2W 21 LKS., NE COR BRIDGE S33 1/2E 20LKS.
- 1960 WIT CARD @ ROWE ENG.; R.J. BLACK, RLS #3384; NO OBJECT STATED; N38E 25.57' NW COR OF N BR. RAIL, N59E 21.42' SW COR OF S BR. RAIL, S11E 12.46' NE COR OF E BR. RAIL, S68W, 30.24' NW COR OF W BR. RAIL
- 1985 UNRECORDED SURVEY BY EDMANDS ENGINEERING FOR WILLIAM MC ALPINE JOB NO. EMS 2262.01 DATED 10-85; FND. 1/2" ROD; NO WITS GIVEN

B. Description of corner evidence found and/or method applied in restoring or reestablishing corner:

- 1996 ROWE ENG.; FIELD, P.S.#37276; FND 1/2" ROD IN MON. BOX ON C/L EXTENSION OF ASPH. ROAD TO E. & 9' E. OF C/L ASPH. ROAD N-S

ACCEPTED FND 1/2" ROD AS BEST EVIDENCE OF ORIGINAL CORNER POSITION


C. Description of monument for corner and accessories established to perpetuate locating the position of the corner:

- A-1 REPLACED 1/2" ROD W/ 5/8" ROD W/STANDARD REMON CAP STAMPED "M 1 T14N R7E" ENCASED IN CONC. IN MON. BOX
- S66°E, 19.13' SET CHIS. + IN TOP W. END CONC. BRIDGE RAIL
- N11°E, 37.84' SET CHIS. + IN TOP NW END CONC. WINGWALL
- S67°W, 44.65' SET CHIS. + IN TOP N. END CONC. BRIDGE RAIL
- N51°W, 45.61' SET 1/2" ROD W/CAP #37276
- N38°E, 97.06' SW CORNER OF CONC. BLOCK HOUSE

NOTE: THIS CORNER IS COMMON WITH M-1 T14N-R7E, M-13 T15N-R7E, A-13 T15N-R8E

Signed by Jonathan M. Field Date 12-4-96
Surveyor's Michigan License No. 37276

APPROVED
12-2-96
RRE
RFB

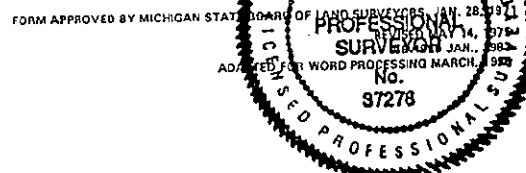

SURVEY &
REMONUMENTATION

MAY 20 1997

COMMISSION

