

1996 REMONUMENTATION PROGRAM
LAND CORNER RECORDATION CERTIFICATE

Filing Requirement of Act 74, Mich. P.A. 1970

RECEIVED FOR RECORD
LIBER NO. _____ PAGE NO. 80
FILE NO. S. Akron

96 DEC 10 AM 8:58

For corners in S. AKRON TWP.

TUSCOLA Located In: _____ Corner Code # _____
(County)

1. Public Land Survey T 14N R 08E A-13 ✓
T 13N R 7E M-1
T 14N R 7E M-13
T 13N R 8E A-1

2. Property Controlling S _____ T _____ R _____
in Section S _____ T _____ R _____

3. Miscellaneous S _____ T _____ R _____
Property in Sec. S _____ T _____ R _____

Jonathan M. Field
TUSCOLA COUNTY
REGISTER OF DEEDS

Register of Deeds Stamp & File Number

4. Lot No. _____ Recorded Plat _____
5. Private Claims _____

I, JONATHAN M. FIELD, in a field survey on MAY 17 19 96, do hereby certify that under requirements of P.A. 74, Michigan P.A. of 1970, the corner points mentioned in lines 1 and 2 above were in conformance with regulations and rules therefore as required in the current manual of survey instructions of the United States Department of the Interior, Bureau of Land Management or by a decree of a Court of Law and/or that the corner points mentioned in lines 3, 4 and 5 above were in conformance with the rules of the Michigan Board of Land Surveyors or by a Decree of a Court of Law; established, re-established, monumented, re-monumented, recovered, found as expressed below:

	A	B	C	D	E	F	G	H	I	J	K	L	M
1													
2	6	5	4	3	2	1							
3													
4	7	8	9	10	11	12							
5													
6	18	17	16	15	14	13							
7													
8	19	20	21	22	23	24							
9													
10	30	29	28	27	26	25							
11													
12	31	32	33	34	35	36							
13													

NOTE: Not more than 4 corners, all in the same town and range, may be recorded on this certificate.

A. Description of original monument and accessories and/or subsequent restoration:
1834 GLO; RISDON, D.S.; SET AS M-1 T13N-R7E; POST; B. ASH 9 S35E 51LKS., TAMARACK 12 S50W 62LKS., W. MAPLE 10 N29W 53LKS., B. ASH 10 N30E 63LKS.


B. Description of corner evidence found and/or method applied in restoring or reestablishing corner:
1996 ROWE ENG.; FIELD, P.S.#37276; FND. 2" PIPE IN MON BOX 23.5' E. OF C/L ASPH. ROAD N-S, 5.5' S. OF C/L ASPH. ROAD TO E., & 10' S. OF C/L ASPH. ROAD TO W.

ACCEPTED FND. PIPE IN MON BOX AS BEST EVIDENCE OF ORIGINAL CORNER POSITION

C. Description of monument for corner and accessories established to perpetuate locating the position of the corner:
A-13 SET 5/8" ROD W/ STANDARD REMON CAP STAMPED "M 1 T13N R7E" INSIDE FND PIPE ENCASED IN CONC. IN MON BOX
N30°E, 37.62' SW CORNER OF W. WINGWALL
S50°E, 27.22' NW CORNER OF W. WINGWALL
N35°W, 86.90' SET NAIL W/TAG #20709 IN E. FACE P.POLE
N59°W, 58.71' SET 1/2" ROD W/CAP #37276

NOTE: THIS CORNER IS COMMON WITH M-1 T13N-R7E, M-13 T14N-R7E, A-1 T13N-R8E

Signed by Jonathan M. Field Date 11-29-96
Surveyor's Michigan License No. 37276

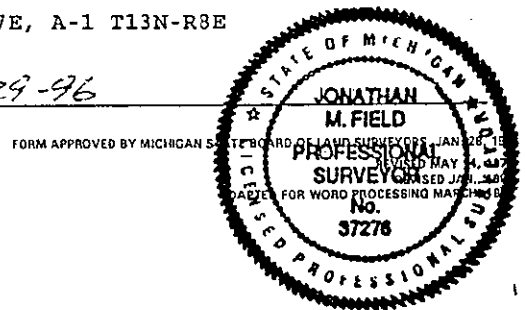

APPROVED
11-27-96
J.M.F.
R.E.B.

COMMISSIONER
REMONUMENTATION
MAY 2 1997
COMMISSION

29

