

1996 REMONUMENTATION PROGRAM
LAND CORNER RECORDATION CERTIFICATE
 Filing Requirement of Act 74, Mich. P.A. 1970

For corners in S. Akron Twp.

| | | |
|------------------------------------|---|---------------|
| <u>Tuscola</u> (County) | Located In: | Corner Code # |
| 1. Public Land Survey | <u>T14N R. 8E</u> | <u>C-13</u> |
| | T <u> </u> R <u> </u> | <u> </u> |
| | T <u> </u> R <u> </u> | <u> </u> |
| | T <u> </u> R <u> </u> | <u> </u> |
| 2. Property Controlling in Section | S <u> </u> T <u> </u> R <u> </u> | <u> </u> |
| | S <u> </u> T <u> </u> R <u> </u> | <u> </u> |
| 3. Miscellaneous Property in Sec. | S <u> </u> T <u> </u> R <u> </u> | <u> </u> |
| | S <u> </u> T <u> </u> R <u> </u> | <u> </u> |

RECEIVED FOR RECORD
 LIBER. NO. _____ PAGE NO. 102
 FILE NO. S. Akron
 96 DEC 10 PM 4:51
 TUSCOLA COUNTY
 REGISTER OF DEEDS
 Register of Deeds Stamp & File Number

4. Lot No. _____, Recorded Plat _____
 5. Private Claims _____

I, Kenneth D. Dunton, in a field survey on June 16, 1996 do hereby state that under requirements of P.A. 74, Michigan P.A. of 1970, the corner points mentioned in lines 1 and 2 above were in conformance with regulations and rules therefore as required in the current manual of survey instructions of the United States Department of the Interior, Bureau of Land Management or by a decree of a Court of Law and for that the corner points mentioned in lines 3, 4 and 5 above were in conformance with the rules of the Michigan Board of Land Surveyors or by a Decree of a Court of Law; established, re-established, monumented, recovered, found as expressed below:

NOTE: Not more than 2 corners, all in the same town and range, may be recorded on this certificate.

| A | B | C | D | E | F | G | H | I | J | K | L | M |
|----|----|----|---|----|---|----|---|----|---|----|---|---|
| 1 | | | | | | | | | | | | |
| 2 | 6 | 5 | | 4 | | 3 | | 2 | | 1 | | |
| 3 | | | | | | | | | | | | |
| 4 | 7 | 8 | | 9 | | 10 | | 11 | | 12 | | |
| 5 | | | | | | | | | | | | |
| 6 | 18 | 17 | | 16 | | 15 | | 14 | | 13 | | |
| 7 | | | | | | | | | | | | |
| 8 | 19 | 20 | | 21 | | 22 | | 23 | | 24 | | |
| 9 | | | | | | | | | | | | |
| 10 | 30 | 29 | | 28 | | 27 | | 26 | | 25 | | |
| 11 | | | | | | | | | | | | |
| 12 | 31 | 32 | | 33 | | 34 | | 35 | | 36 | | |
| 13 | | | | | | | | | | | | |

A. Description of original monument and accessories and/or subsequent restoration:

G.L.O. 1821 Date Unknown, Survey of Sec. 32, T14N-R8E.
 Joseph Wampler, D.S. Edward Teskey, Co. Surveyor (1895-1898)
 Set post cor. Secs. 31 & 32 Gas Pipe.
 Elm 14 N 69 E 35
 Sugar 12 S 21 W 16

Note: Sec. A continued on back of form.

B. Description of corner evidence found and/or method applied in restoring or reestablishing corner:

Found 1/2" rod over 1/2" x 36" rod in 1" pipe in cedar post in rocks.
 Held rod, pipe & post found as the best evidence of the original corner.


C. Description of monument for corner and accessories established to perpetuate locating the position of the corner:

Removed rods, pipe & post and placed standard monument stamped Corner C-13, T14N-R8E. Placed mon. box over monument.
 S30°W 58.66' fnd. 11192 tag & nail in NE face P. pole.
 S66°W 69.53' chiseled notch atop E. end 72" CSP.
 West 79.20' fnd. 1/2" rod @ apparent Cor. C-1, T13N-R7E.
 N60°W 56.12' fnd. 11192 tag & nail in SE face T. pole stub.

Signed by [Signature]
 Surveyor's Michigan License No. 23503

Date 11-25-96

APPROVED
11-25-96
 [Signatures]

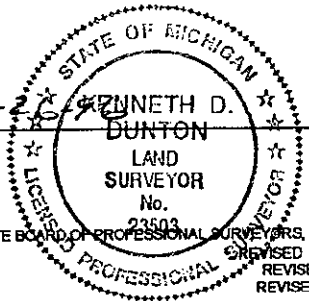

FORM APPROVED BY MICHIGAN STATE BOARD OF PROFESSIONAL SURVEYORS, JAN. 28, 1971
 REVISED MAY 14, 1975
 REVISED JAN., 1983
 REVISED OCT., 1995

MAY 20 1997

Fnd. 1/2" iron rod 16" deep. Raised to surface with 1/2" rod & RLS 11192 cap.
S30°00'W 58.55' RLS 11192 tag in P.P.
N59°34'W 55.80' RLS 11192 tag in Tele. guy pole.
N33°54'E 50.65' RLS 11192 tag in T.P.
N76°00'W 85.90' E. edge E. leg of sign post.
S26°19'W 16.15' W. edge W. leg of sign post.
West 79.20' to 1/2" rod @ NE cor. Sec. 6, T13N-R8E.
North 3.5'± to centerline pavement.

