

1996 REMONUMENTATION PROGRAM
 LAND CORNER RECORDATION CERTIFICATE
 Filing Requirement of Act 74, Mich. P.A. 1970

For corners in S. Akron Twp.

<u>Tuscola</u> (County)	Located In:	Corner Code #
1. Public Land Survey	T14NR 8E	E-13
	T ___ R ___	_____
	T ___ R ___	_____
	T ___ R ___	_____
2. Property Controlling in Section	S ___ T ___ R ___	_____
	S ___ T ___ R ___	_____
3. Miscellaneous Property in Sec.	S ___ T ___ R ___	_____
	S ___ T ___ R ___	_____

RECEIVED FOR RECORD
 LIBER NO. _____ PAGE NO. 100
 FILE NO. S. Akron
 96 DEC 10 PM 4:51
 TUSCOLA COUNTY
 REGISTERED DEEDS

Register of Deeds Stamp & File Number

4. Lot No. _____, Recorded Plat _____
 5. Private Claims _____

I, Kenneth D. Dunton in a field survey on June 16, 1996 do hereby state that under requirements of P.A. 74, Michigan P.A. of 1970, the corner points mentioned in lines 1 and 2 above were in conformance with regulations and rules therefore as required in the current manual of survey instructions of the United States Department of the Interior, Bureau of Land Management or by a decree of a Court of Law and /or that the corner points mentioned in lines 3, 4 and 5 above were in conformance with the rules of the Michigan Board of Land Surveyors or by a Decree of a Court of Law; established, re-established, monumented, recovered, found as expressed below:

NOTE: Not more than 2 corners, all in the same town and range, may be recorded on this certificate.

A	B	C	D	E	F	G	H	I	J	K	L	M
1												
2	6	5	4	3	2	1						
3												
4	7	8	9	10	11	12						
5												
6	18	17	16	15	14	13						
7												
8	19	20	21	22	23	24						
9												
10	30	29	28	27	26	25						
11												
12	31	32	33	34	35	36						
13												

A. Description of original monument and accessories and/or subsequent restoration:

G.L.O. 1821	Date Unknown	June 12, 1891
Joseph Wampler, D.S.	Survey of Sec. 32, T14N-R8E.	G. B. Felton, Co.
Set post cor. Secs. 32 & 33	by E. J. Teskey, Co. Surveyor	Surveyor. Sec. 33,
Lynn 6 S 12 1/2 E 14	(1895-1898)	T14N-R8E
Sugar 12 N 7 1/2 W 8	King bolt	From B.T.'s, long
	Double Maple N20°E 85 1/2	thin stone & earthen
		cone. Double Maple
		5 N 20 E 85 1/2

Note. Section A continued on back of form.

B. Description of corner evidence found and/or method applied in restoring or reestablishing corner:

Found 1" hex shaped iron rod. Held 1" hex rod as the best evidence of the original corner. Note: Upon removal of hex rod it was determined that it was an 8" long chisel. Found rock pile & clay tile below chisel.


C. Description of monument for corner and accessories established to perpetuate locating the position of the corner:

Removed 1" hex rod and placed a standard monument stamped corner E-13, T14N-R8E. Placed monument box over monument.
 S40°E 28.35' chiseled "+" atop S. end of 46' MPPA.
 N40°E 31.15' chiseled "+" atop N. end of 46' MPPA.
 West 70.29' fnd. 1 3/4" pipe in mon. box at apparent cor. E-1, T13N-R8E.
 N60°E 88.38' set T. C. Remon. tag & spike in S. face P. pole.

Signed by *Kenneth D. Dunton*
 Surveyor's Michigan License No. 23503

Date _____

APPROVED
 11-25-96
J.B.E.
J.M.T.
R.B.B.

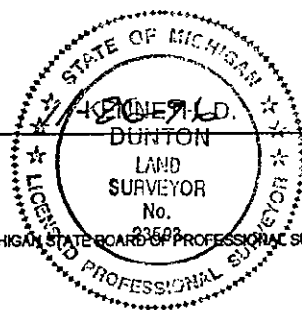

FORM APPROVED BY MICHIGAN STATE BOARD OF PROFESSIONAL SURVEYORS, JAN. 28, 1971
 REVISED MAY 14, 1975
 REVISED JAN., 1983
 REVISED OCT., 1995

MAY 20 1997

29

