

1996 REMONUMENTATION PROGRAM
LAND CORNER RECORDATION CERTIFICATE
 Filing Requirement of Act 74, Mich. P.A. 1970

For corners in S. Akron Twp.

Tuscola Located in: Corner Code #
 (County)

1. Public Land Survey T14NR 8E J-13
 T R
 T R
 T R
 T R

2. Property Controlling in Section S T R
 S T R
 S T R

3. Miscellaneous Property in Sec. S T R
 S T R

TUSCOLA COUNTY
 REGISTERED DEEDS

96 DEC 10 PM 4:51

RECEIVED FOR RECORD
 LIBER NO. _____ PAGE NO. 95
 FILE NO. S. Akron

Register of Deeds Stamp & File Number

4. Lot No. _____, Recorded Plat _____
 5. Private Claims _____

I, Kenneth D. Dunton in a field survey on June 15, 1996 do hereby state that under requirements of P.A. 74, Michigan P.A. of 1970, the corner points mentioned in lines 1 and 2 above were in conformance with regulations and rules therefore as required in the current manual of survey instructions of the United States Department of the Interior, Bureau of Land Management or by a decree of a Court of Law and for that the corner points mentioned in lines 3, 4 and 5 above were in conformance with the rules of the Michigan Board of Land Surveyors or by a Decree of a Court of Law; established, re-established, monumented, recovered, found as expressed below.

NOTE: Not more than 2 corners, all in the same town and range, may be recorded on this certificate.

| | A | B | C | D | E | F | G | H | I | J | K | L | M |
|----|----|---|----|---|----|---|----|---|----|---|----|---|---|
| 1 | | | | | | | | | | | | | |
| 2 | 6 | | 5 | | 4 | | 3 | | 2 | | 1 | | |
| 3 | | | | | | | | | | | | | |
| 4 | 7 | | 8 | | 9 | | 10 | | 11 | | 12 | | |
| 5 | | | | | | | | | | | | | |
| 6 | 10 | | 17 | | 16 | | 15 | | 14 | | 13 | | |
| 7 | | | | | | | | | | | | | |
| 8 | 19 | | 20 | | 21 | | 22 | | 23 | | 24 | | |
| 9 | | | | | | | | | | | | | |
| 10 | 30 | | 29 | | 28 | | 27 | | 26 | | 25 | | |
| 11 | | | | | | | | | | | | | |
| 12 | 31 | | 32 | | 33 | | 34 | | 35 | | 36 | | |
| 13 | | | | | | | | | | | | | |

A. Description of original monument and accessories and/or subsequent restoration:

G.L.O. 1821 April 28, 1896
 Joseph Wampler, D.S. Edward L. Teskey, Co. Surveyor
 Set 1/2 mile post Section 35, T14N-R8E
 Ironwood N48W 7 Set proportionate between Section corners. Stone 8 x 20 x 3
 Lynn S88E 2 and crockery at corner. B. Oak
 8 S 73 1/2 W 263 1/2. Apple 8
 S 27 E 119 1/2

Aug. 1971 L.C.R.C. form filed by David T. Rowe RLS 11192 Page 7, S. Akron Twp Re-set "T" iron using government distances North 5.4' C/L of M-138. S05°E 16.51' west leg of sign. S10°E 17.36' east leg of sign.

Note: Section A continued on back of form.

B. Description of corner evidence found and/or method applied in restoring or reestablishing corner.

Found monument box (empty). Held center lug as the best evidence of the original corner position.


C. Description of monument for corner and accessories established to perpetuate locating the position of the corner:

Encased 5/8" rod & standard brass cap stamped J-13, T14N R8E in concrete in monument box.
 West 56.20' center lug on mon. box (empty) apparent cor. J-1, T13N-R8E.
 N66°W 68.80' fnd. nail in NE face P. pole.
 N45°W 46.75' fnd. "T" iron.
 N45°E 47.09' fnd. 1/2" rod & cap #33986.

Signed by [Signature]
 Surveyor's Michigan License No. 23503

Date _____

APPROVED
 11-25-96
 [Signatures]

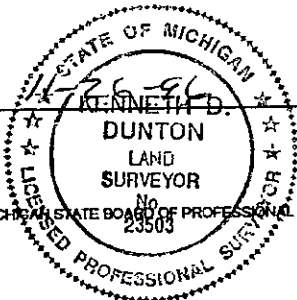

FORM APPROVED BY MICHIGAN STATE BOARD OF PROFESSIONAL SURVEYORS, JAN. 28, 1971
 REVISED MAY 14, 1975
 REVISED JAN., 1983
 REVISED OCT., 1995

Aug. 5, 1971 Survey by David T. Rowe, RLS #11192, Liber 1-Page 272
"T" iron.

North 5.4' C/L of M-138.

S05°E 16.51' West leg of sign.

West 56.10' N 1/4 cor. Sec. 2, T13N-R8E (P.K. nail)

Mar. 31, 1972 Survey by David T. Rowe, RLS #11192, Liber 1-Page 419
"T" iron. Same accessories as L-1, P-272.

June 22, 1972 Survey by David T. Rowe, RLS #11192, Liber 2-Page 19.
Fnd. "T" iron. Same accessories as L-1, Page 419.

April 17, 1974 Survey by Robert G. Kay, RLS #14096, Liber 440-Page 29.
No mention of object found.

North 5.42' C/L road.

N45°E 55.55' 2" sign post.

N75°W 68.15' 2" grd. pipe @ P.P.

Feb. 19, 1979 Survey by Glenn A. Fauser, RLS #18657, Liber 447-Pages 1450 & 1451.
Fnd. mon. box, no mention of accessories.

June 29, 1980 Survey by Jan S. Fokens RLS #21567, Liber 507-Pages 559 & 560.
Top cent. lug - mon. box.

West 56.20' top center of mon. box.

N75°W 68.83' set nail w/flag in N. face P.P.

N45°E 55.55' rd. sign post.

Sept. 25, 1989 L.C.R.C. form filed by Stephan J. Szyszkoski, L.S. #33986,
Page 63, S. Akron Twp.

Top cent. lug mon. box.

West 56.20' top center of mon. box.

N75°W 68.83' set nail/flag N. face P.P.

N45°E 55.55' rd. sign post.

S20°E 18.09' W. edge W. leg of sign.


N45°E 46.95' set 1/2" re-rod w/cap #33986.

Sept. 25, 1989 Survey by Stephan J. Szyszkoski, L.S. #33986, Liber 597-Pages
377 & 378.

Top cent. lug mon. box.

Same accessories as L.C.R.C. Page 63.

Sec. 35, T14N-R8E

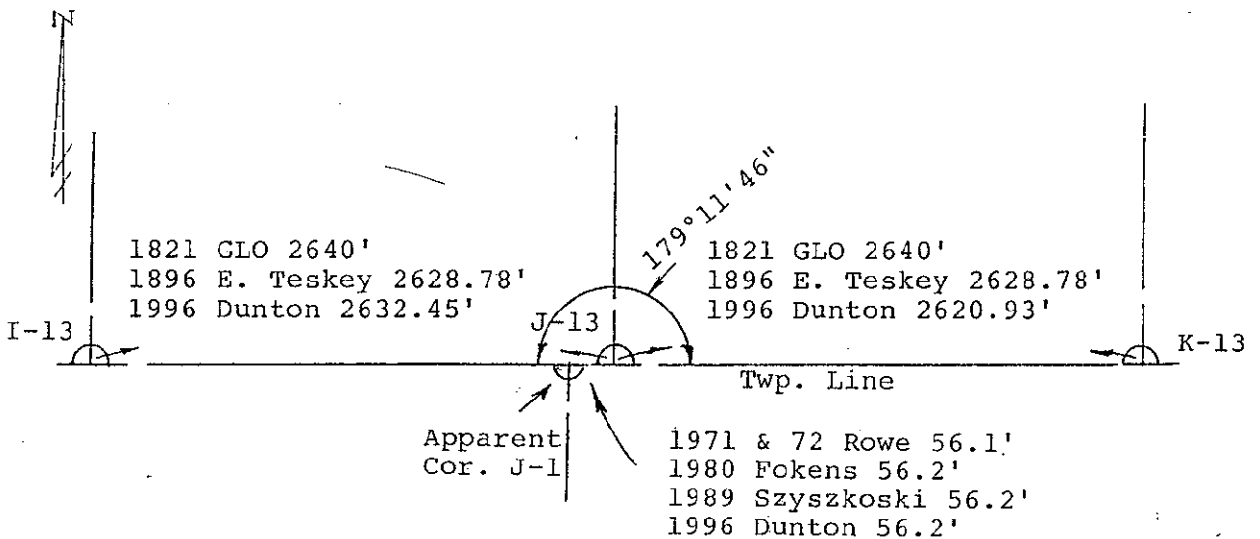

Sec. 2, T13N-R8E