

1996 REMONUMENTATION PROGRAM
 LAND CORNER RECORDATION CERTIFICATE
 Filing Requirement of Act 74, Mich. P.A. 1970

For corners in S. Akron Twp.

Tuscola Located In: Corner Code #
 (County)

1. Public Land Survey T14NR 8E K-13
 T R
 T R
 T R

2. Property Controlling S T R
 in Section S T R
 3. Miscellaneous S T R
 Property in Sec. S T R

REGISTERED FOR RECORD
 INDEX NO. PAGE NO. 94
 FILE NO. S. Akron
 56 DEC 10 PM 4:51
 Register of Deeds Stamp & File Number

4. Lot No. _____, Recorded Plat _____
 5. Private Claims _____

	A	B	C	D	E	F	G	H	I	J	K	L	M
1													
2	6		5		4		3		2		1		
3													
4	7		8		9		10		11		12		
5													
6	18		17		16		15		14		13		
7													
8	19		20		21		22		23		24		
9													
10	30		29		28		27		26		25		
11													
12	31		32		33		34		35		36		
13													

I, Kenneth D. Dunton in a field survey on June 15 1996 do hereby state that under requirements of P.A. 74, Michigan P.A. of 1970, the corner points mentioned in lines 1 and 2 above were in conformance with regulations and rules therefore as required in the current manual of survey instructions of the United States Department of the Interior, Bureau of Land Management or by a decree of a Court of Law and/or that the corner points mentioned in lines 3, 4 and 5 above were in conformance with the rules of the Michigan Board of Land Surveyors or by a Decree of a Court of Law; established, re-established, monumented, recovered, found as expressed below:

NOTE: Not more than 2 corners, all in the same town and range, may be recorded on this certificate.

A. Description of original monument and accessories and/or subsequent restoration:

G.L.O. 1821 April 28, 1896
 Joseph Wampler, D.S. Edward L. Teskey, County Surveyor
 Corner Secs. 35 & 36 Survey of Section 35, T14N-R8E, Pages 288 & 289
 is an Ash 10" diam. Previously established
 No accessories given. Elm 12 N 53 1/2 W 120
 Maple 2 N 72 E 148

Note: Section A continued on back of form.

B. Description of corner evidence found and/or method applied in restoring or reestablishing corner:

Found P.K. nail & tag #23857 (W. J. Winiarski). Held P.K. nail & tag as the best evidence of the original corner.


C. Description of monument for corner and accessories established to perpetuate locating the position of the corner:

Removed P.K. & tag and set standard monument stamped corner K-13, T14N-R8E.
 Set monument box over monument.
 S05°W 53.22' fnd. M.S.H.D. tag & spike in E. face P. pole.
 West 59.54' center lug on monument box cover, apparent cor. K-1, T13N-R8E.
 N45°W 33.99' set 1/2" x 18" rod & cap #23503 in road shoulder.
 N30°E 70.99' set T.C. remon. tag & spike in SE face T.P. stub.
 East 9'± physical centerline of pavement to north.

Signed by [Signature]
 Surveyor's Michigan License No. 23503

Date _____

APPROVED
 11-25-96
 [Signatures]

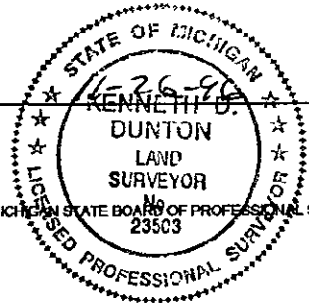

FORM APPROVED BY MICHIGAN STATE BOARD OF PROFESSIONAL SURVEYORS, JAN. 28, 1971
 REVISED MAY 14, 1975
 REVISED JAN., 1983
 REVISED OCT., 1985

MAY 29 1997

June 29, 1980 Survey by Jan S. Fokens, L.S. #21567, Liber 507-Pages 559 & 560.

Fnd. P.K. nail.

West 59.57' top cent. of mon. box.

S05°W 53.23' nail w/MSHD tag in P.P.

N45°E 70.80' P.K. w/flag in T.P.

Sept. 25, 1989 L.C.R.C. form filed by Stephan J. Szyszkoski, L.S. #33986, Page 63, S. Akron Twp.

Re-set P.K. nail using accessories from L-507, Pages 559 & 560.

West 59.65' to iron in mon. box.

S05°W 53.23' nail w/MSHD tag in P.P.

N45°W 48.60' face rd. sign post @ C/L-C/L rd. grade.

East, 9± C/L Sheridan Rd. north.

Sept. 25, 1989 Survey by Stephan J. Szyszkoski, L.S. #33986, Liber 597-Pages 377 & 378.

Re-set P.K. nail w/brass tag. Same accessories as L.C.R.C. Page 63.

