
1996 REMONUMENTATION PROGRAM

LAND CORNER RECORDATION CERTIFICATE
Filing Requirement of Act 74, Mich. P.A. 1970 For corners in S. Akron Twp.
Tuscola Located In: Corner Code #
1. Public Land Survey T 4NR 8E L-13 T R T R
2. Property Controlling S T R in Section S T R 3. Miscellaneous S T R Property in Sec. S T R R Register of Deeds Stamp & File Number
4. Lot No, Recorded Plat
5. Private Claims I, Kenneth D. Dunton in a field survey on June 15, 19 96 do hereby state that under requirements of P.A. 74, Michigan P.A. of 1970, the corner points mentioned in lines 1 and 2 above were in
conformance with regulations and rules therefore as required in the current manual of survey instructions of the United States Department of the Interior, Bureau of Land Management or by a decree of a Court of Law and /or that the corner points mentioned in lines 3, 4 and 5 above were in conformance with the rules of the Michigan Board of Land Surveyors or by a Decree of a Court of Law; established, re-established, monumented, recovered, found as expressed below:
NOTE: Not more than 2 corners, all in the same town and range, may be recorded on this certificate.
A. Description of original monument and accessories and/or subsequent restoration:
G.L.O. 1821 Joseph Wampler,D.S. Set 1/2 mile Post Birch 7 N 40 E 40 Ash 14 S 70 W 36 May 24, 1980 L.C.R.C. form filed by Douglas W. Hooth, L.S. #7966 Page 40, S. Akron Twp. Set 5/8" re-rod in mon. box by proportionate measure. N87°33'W 30.09' N 1/4 cor. Sec. 1. N55°E 45.77' 36" stump. N65°E 92.28' 30" Maple. South 1.05' S'ly. edge M-138.
B. Description of corner evidence found and/or method applied in restoring or reestablishing corner:
Found 3/4" rod in monument box. Held rod as the best evidence of the original corner.
C. Description of monument for corner and accessories established to perpetuate locating the position of the corner:
Drove 3/4" rod down & placed standard brass cap & 5/8" rod above. Encased cap & rod in concrete in monument box. Stamped cap corner L-13, T14N-R8E. South 9.96' set 1/2" x 18" rod & cap #23503. North 24.97' set 1/2" x 18" rod & cap #23503. S71°35'W 31.76' set 1/2" x 18" rod & cap #23503. S89°57'40"W 30.05' fnd. 1/2" rod at apparent cor. L-1, T13N-R8E.
Signed by
Surveyor's Michigan License No. LAND SURVEYOR SURVEYOR
APPROVED FORM APPROVED BY MICHIGAN STATE BOARD STORESSIONAL SURVEYORS, JAN. 28, 1971 11-25-96 11-25-96 REVISED JAN, 1983 REVISED OCT., 1995

MAY 8 0 1097

36

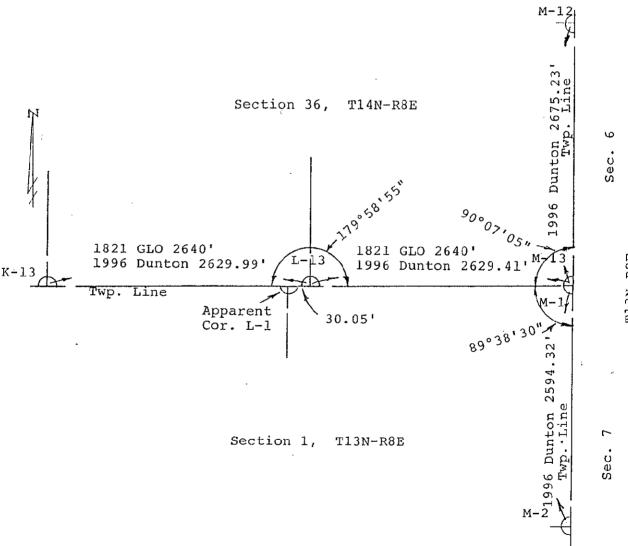

Tl3N-R9E