

1993

COMMISSION

1993 REMONUMENTATION PROGRAM  
LAND CORNER RECORDATION CERTIFICATE  
Filing Requirement of Act 74, Mich. P.A. 1970  
S. AKRON TOWNSHIP

RECEIVED FOR RECORD  
LIBER NO. PAGE 113 28  
FILED NO. S. AKRON  
93 DEC 10 PM 12:02  
MICHIGAN STATE BOARD OF LAND SURVEYORS  
TUSCOLA COUNTY  
REGISTER OF DEEDS

For corners in

TUSCOLA  
(County)

Located In:

Corner Code ##

- 1. Public Land Survey      T 14N R 8E      M-2  
    T \_\_\_\_\_ R \_\_\_\_\_  
    T \_\_\_\_\_ R \_\_\_\_\_  
    T \_\_\_\_\_ R \_\_\_\_\_
- 2. Property Controlling      S \_\_\_\_\_ T \_\_\_\_\_ R \_\_\_\_\_  
    in Section                    S \_\_\_\_\_ T \_\_\_\_\_ R \_\_\_\_\_
- 3. Miscellaneous            S \_\_\_\_\_ T \_\_\_\_\_ R \_\_\_\_\_  
    Property in Sec.            S \_\_\_\_\_ T \_\_\_\_\_ R \_\_\_\_\_

Register of Deeds Stamp & File Number

- 4. Lot No. \_\_\_\_\_, Recorded Plat \_\_\_\_\_
- 5. Private Claims \_\_\_\_\_

	A	B	C	D	E	F	G	H	I	J	K	L	M
2	6		5		4		3		2		1		C
3													
4	7		8		9		10		11		12		
5													
6	18		17		16		15		14		13		
7													
8	19		20		21		22		23		24		
9													
10	30		29		28		27		26		25		
11													
12	31		32		33		34		35		36		
13													

I, Kenneth D. Dunton, in a field survey on Sept. 5, 19 93, do hereby certify that under requirements of P.A. 74, Michigan P.A. of 1970, the corner points mentioned in lines 1 and 2 above were in conformance with regulations and rules therefore as required in the current manual of survey instructions of the United States Department of the Interior, Bureau of Land Management or by a decree of a Court of Law and/or that the corner points mentioned in lines 3, 4 and 5 above were in conformance with the rules of the Michigan Board of Land Surveyors or by a Decree of a Court of Law; established, re-established, monumented, re-monumented, recovered, found as expressed below:

**NOTE: Not more than 4 corners, all in the same town and range, may be recorded on this certificate.**

A. Description of original monument and accessories and/or subsequent restoration:

1821 G.L.O. Notes  
Joseph Wampler, D.S.  
Set 1/2 mile Post  
Sugar 9" N51°W 13.20'  
Lynn 10" N67°E 1.98'

March 23, 1972 Survey Liber 1 - Page 449 by Harold N. Elrich, R.L.S. #18986. Found monument box. N01°49'E 71.87' to "+" in conc. @ cor. A-4, T14N-R9E.  
April 27, 1972 Survey Liber 1 - Page 444 by Harold N. Elrich, R.L.S. #18986. Same evidence and accessory as shown on Survey Liber 1 - Page 449.

Note: Section A. continued on back of form.

B. Description of corner evidence found and/or method applied in restoring or reestablishing corner:

Found 1/2" re-rod in water valve box (similar to mon. box - slightly smaller diameter - labeled "water valve") No knowledge of fate of 1" rod & mon. box per 1980 Act 74, page 42. Two accessories from 1980 check 1/2" rod in valve box. N02°41'E 71.87' 3/4" re-rod in mon. box & S85°E 66.10' NW cor. house.  
Accepted 1/2" re-rod in valve box as corner M-2, T14N-R8E.

**COPY**

C. Description of monument for corner and accessories established to perpetuate locating the position of the corner:

Placed 3/4" pipe over 1/2" re-rod & 5/8" re-rod with 2" brass cap in 3/4" pipe. Encased re-rod & pipe in concrete. Stamped brass cap, corner M-2, T14N-R8E.  
N02°36'30"E 71.83' found 5/8" rod in mon. box at apparent cor. A-4, T14N-R9E.  
S59°42'W 60.30' center of 2" pipe corner post in concrete.  
N62°39'W 51.98' set T. C. Re-mon. tag & spike in E. face of p. pole.  
S41°11'E 70.54' set T. C. Re-mon. tag & spike in W. face of guy pole.  
S84°33'E 66.03' NW corner of footings @ house #6196.  
S86°38'E 22.00' set p. k. nail & galvanized washer in asphalt pavement.

Signed by

*Kenneth D. Dunton*

Date Nov. 22, 1993


Surveyor's Michigan License No.

23503

APPROVED  
11-22-93

*K.D.D.*  
*S.P.E.*


FORM APPROVED BY MICHIGAN STATE BOARD OF LAND SURVEYORS, JAN. 26, 1971, REVISED MAY 14, 1975, REVISED JAN., 1983

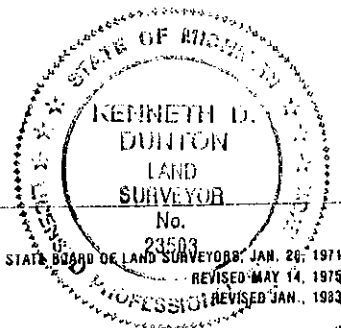

Section A. continued from front of form:

Feb. 26, 1980 Act 74, T14N-R8E, page 42 by Douglas W. Hooth, R.L.S. #7966. Found 1" iron rod in mon. box.

- S85°E NW cor. house 66.10'
- S42°E guy pole 53.39'
- N57°W p. pole 40.56'
- N02°41'E W 1/4 cor. Sec. 7 71.87'
- (3/4" re-rod in mon. box)

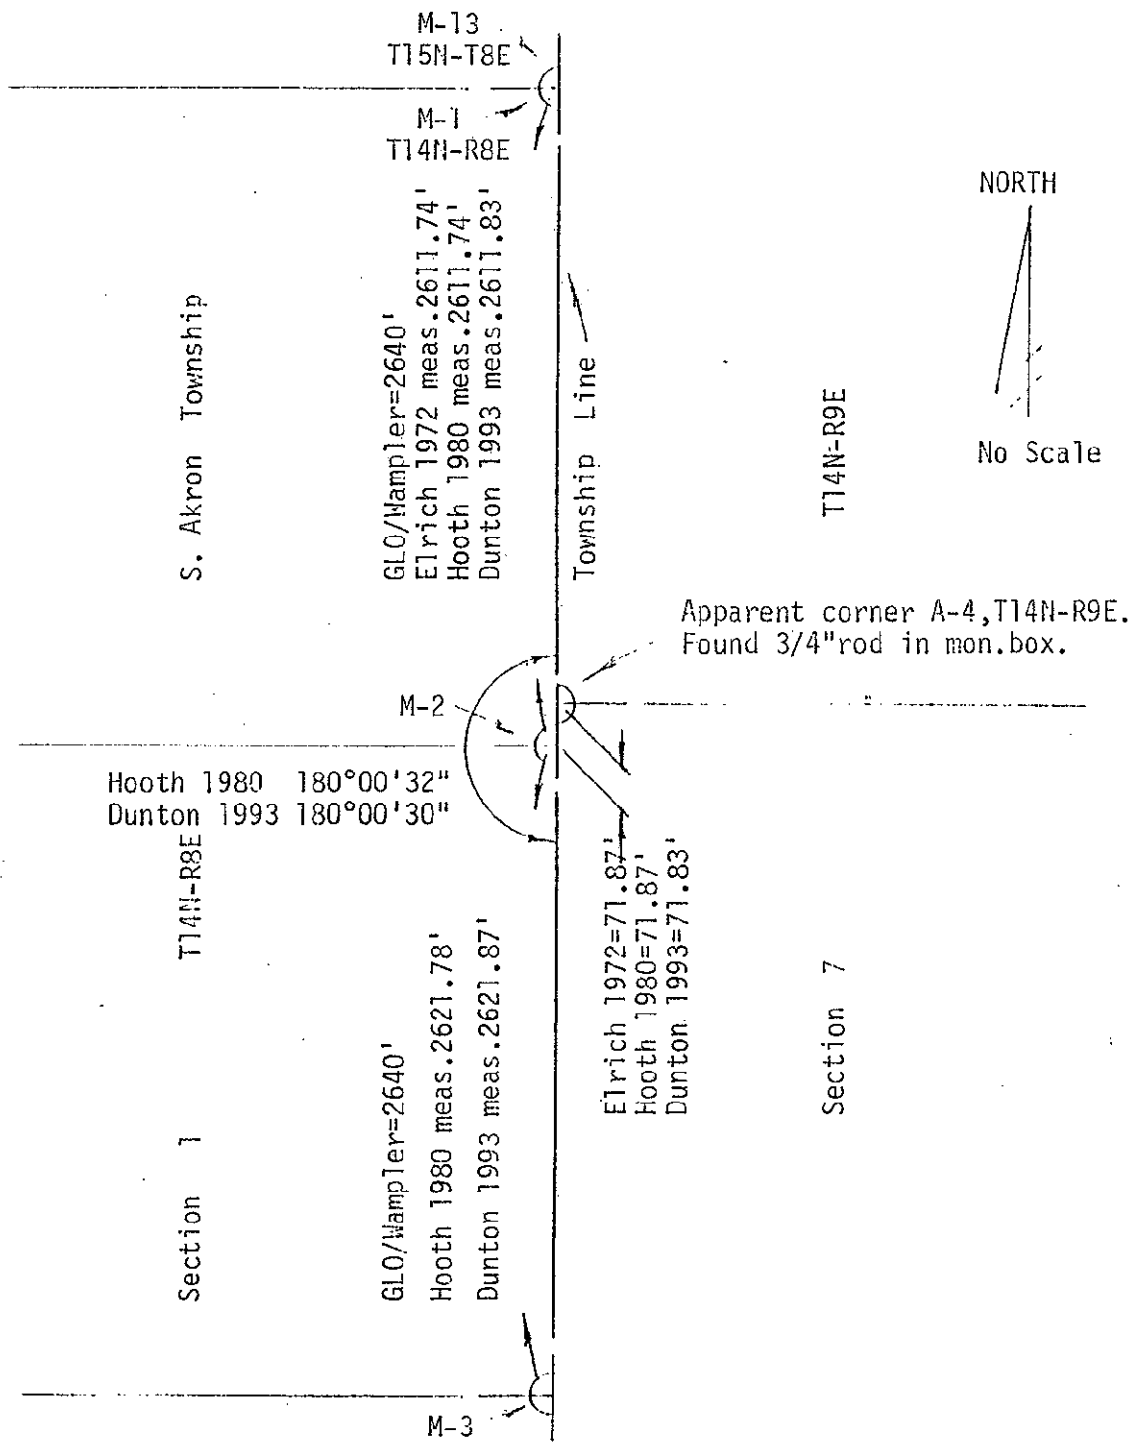

COPY