

**1997 REMONUMENTATION PROGRAM  
LAND CORNER RECORDATION CERTIFICATE**  
Filing Requirement of Act 74, Mich. P.A. 1970

For corners in: COLUMBIA TWP.

<u>TUSCOLA</u> (County)	Located In:	Corner Code #
1. Public Land Survey	<u>T 14N R 09E</u>	<u>C-13</u>
	T _____ R _____	_____
	T _____ R _____	_____
2. Property Controlling in Section	S _____ T _____ R _____	_____
	S _____ T _____ R _____	_____
3. Miscellaneous Property in Sec.	S _____ T _____ R _____	_____
	S _____ T _____ R _____	_____

RECEIVED FOR RECORD  
LIBER NO. \_\_\_\_\_ PAGE NO. \_\_\_\_\_  
FILE NO. #53  
COLUMBIA TWP. TOWNSHIP  
97 OCT -7 PM 3:01  
TUSCOLA COUNTY  
REGISTER OF DEEDS

Register of Deeds Stamp & File Number

4. Lot No. \_\_\_\_\_ Recorded Plat \_\_\_\_\_  
5. Private Claims \_\_\_\_\_

1	A	B	C	D	E	F	G	H	I	J	K	L	M
2	6	5	4	3	2	1							
3													
4	7	8	9	10	11	12							
5													
6	18	17	16	15	14	13							
7													
8	19	20	21	22	23	24							
9													
10	30	29	28	27	26	25							
11													
12	31	32	33	34	35	36							
13													

I, JONATHAN M. FIELD, in a field survey on JULY 23 19 97, do hereby certify that under requirements of P.A. 74, Michigan P.A. of 1970, the corner points mentioned in lines 1 and 2 above were in conformance with regulations and rules therefore as required in the current manual of survey instructions of the United States Department of the Interior, Bureau of Land Management or by a decree of a Court of Law and/or that the corner points mentioned in lines 3, 4 and 5 above were in conformance with the rules of the Michigan Board of Land Surveyors or by a Decree of a Court of Law; established, re-established, monumented, re-monumented, recovered, found as expressed below:

NOTE: Not more than 4 corners, all in the same town and range, may be recorded on this certificate.


A. Description of original monument and accessories and/or subsequent restoration:  
1835 GLO; PARKE, D.S.; SET POST; W.OAK 17 N62 1/2E 17LKS., LYNN 7 N88 1/2W 15LKS.  
1980 HOOTH, LS#7966; LCRC PG.38; FND. 1/2" ROD 12" DEEP (IN MON BOX); N62E 66.67' P.POLE, S15W 22.33' FACE OF ROAD SIGN POST, S88E 41.81' NE COR. SEC.6, N45E 51.48' FACE OF GAS MARKER, NORTH 8.4' N. EDGE BIT. ROAD  
1983 DUNTON, P.S.#23503; SURVEY L.538, PG.726; CORNER SHOWN; NO OBJECT STATED, NO WITS GIVEN  
1988 ROWE; BROWN, P.S.#33134; SURVEY L.587 PG.758-759; CORNER SHOWN, NO OBJECT STATED; NO WITS GIVEN, DIST. OF 41.82' SHOWN TO C-1 T13N-R9E

B. Description of corner evidence found and/or method applied in restoring or reestablishing corner;  
1997 ROWE; FIELD, PS#37276; FND. 1/2" ROD IN MON, BOX; RECOVERED 2 PREVIOUS WITNESSES WHICH INDICATE THAT FND. ROD IS IN SAME POSITION AS 1980 HOOTH LCRC CITED IN SECTION A. ABOVE

ACCEPTED FND. ROD AS BEST AVAILABLE EVIDENCE OF ORIGINAL CORNER POSITION

C. Description of monument for corner and accessories established to perpetuate locating the position of the corner:  
C-13 REPLACED 1/2" ROD W/ 5/8" ROD & STANDARD REMON. CAP STAMPED C 13 T14N R9E IN CONC. IN MON. BOX EAST, 41.83' FND. 1/2" ROD APPARENT C-1 T13N-R9E  
N59°E, 66.64' NAIL W/MDOT TAG IN SE FACE P.POLE (FND NAIL W/TAG)  
S61°E, 59.87' W. EDGE OF YIELD SIGN POST  
N24°W, 26.18' E. EDGE OF YIELD SIGN POST  
S59°W, 30.37' 1/2" ROD W/CAP #37276 (SET ROD W/CAP)  
N38°W, 23.59' 1/2" ROD W/CAP #37276 (SET ROD W/CAP)

Signed by Jonathan M. Field Date 9-10-97  
Surveyor's Michigan License No. 37276

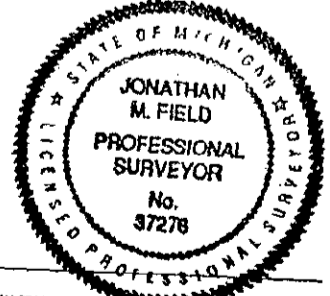

SURVEY &  
REMONUMENTATION  
COMMISSION  
NOV 26 1997

APPROVED  
9-8-97  
*[Handwritten initials]*

FORM APPROVED BY MICHIGAN STATE BOARD OF LAND SURVEYORS, JAN. 22, 1971  
REVISED MAY 14, 1975  
REVISED JAN., 1983  
ADAPTED FOR WORD PROCESSING MARCH, 1993

