1997 REMONUMENTATION PROGRAM LAND CORNER RECORDATION CERTIFICATE

Filing Requirement of Act 74, Mich. P.A. 1970

For corners in: COLUMBIA T	₩ P.	ţ	·	11800 11800	J. J. J.	001 -	C NO.	EIVED
TUSCOLA	Located In:	Corner Code #		27% 1214 1214 1214	7	1/8	10/20	71 O
(Cimty)				510 EUC	\$	The Co	2	23
1. Public Land Survey	T <u>14N</u> R <u>09E</u> T R T R T R			in the second se	5	3: 02	E NO.	ECORD
2. Property Controlling S	T R					`	ti i	
	T R T R	R	Register of Deeds Stamp & File Number					
Property in Sec. S	TR				· · · · · · · · · · · · · · · · · · ·			
			, A B	C D	É F	G Н	IJĸ	C L N
4. Lot No, Record 5. Private Claims	ed Plat		2 6	5	4	3	2	1
			4 7	Ą	- 9	10	11	12
1, JONATHAN M. FIELD , in a field survey on JULY 23 19 97 , do hereby certify that under requirements of P.A. 74, Michigan P.A. of 1970, the corner points mentioned in lines 1 and 2 above were in conformance with regulations and rules therefore as required in the current manual of survey instructions of the United States Department of the Interior, Bureau of Land Management or by a decree of a Court of Law and/or that the corner points mentioned in lines 3, 4 and 5 above were in conformance with the rules of the Michigan Board of Land Surveyors or by a Decree of a			6 18	17	16	15	14	- 13
			7 8 19	20	21	22	23	24
Court of Law; established, re-established, monumented, re-monumented, recovered, found as expressed below:		10 30	29	28	27	26	25	
NOTE: Not more than 4 corners, all in the same town and range, may be recorded on this certificate.			11 31	32	33	34	35	36
A. Description of original monu		t/or subsequent restoration:						

1983 DUNTON, P.S.#23503; SURVEY L.538, PG.726; FND. 1" PIPE; N88E 43.3' APPARENT N 1/4 COR. SEC.5; NORTH 4' C/L **PAVEMENT**

1988 ROWE; BROWN, P.S.#33134; SURVEY L.587 PG.758-759; NO OBJECT STATED; NO WITS GIVEN, DIST. OF 43.36' SHOWN TO D-1 T13N-R9E

Description of corner evidence found and/or method applied in restoring or reestablishing corner.

1997 ROWE; FIELD, PS#37276; FND. 1 1/2" PIPE; RECOVERED 1 PREVIOUS WITNESS WHICH INDICATES THAT FND. PIPE IS IN SAME POSITION AS 1983 DUNTON SURVEY CITED IN SECTION A. ABOVE

FND. LARGE STONES 1.5'± BELOW PIPE ALSO FRAGMENTS OF WOOD

ACCEPTED FND PIPE AS BEST AVAILABLE EVIDENCE OF ORIGINAL CORNER POSITION

Description of monument for corner and accessories established to perpetuate locating the position of the corner: REPLACED FND. PIPE W/ STD. REMON. MONUMENT STAMPED D 13 T14N R9E IN MON. BOX

EAST, 43.38' FND. 3/4" PIPE APPARENT D-1 T13N-R9E

NO1°W, 17.92' NAIL W/TAG #11192 IN SW FACE 8" POST (FND NAIL W/TAG) S29°W, 24.70' CHIS. NOTCH IN SW END 12" CMP

S69°W, 26.40' 1/2" ROD W/CAP #37276 (SET ROD W/CAP)

N52°E, 28.19' 1/2 "ROD W/CAP #37276 N52°E, 28.19' 1/2 "ROD W/CAP #37276 (SET ROD W/CAP) NORTH, 18.58' 1/2" ROD W/CAP #23503 (FND ROD W/CAP)

Signed by Surveyor's Michigan License No.

ORVEYOR8, JAN. 21, 1171

OF MICH

NAHTANOL M. FIELD


PROFESSIONAL SURVEYOR Nο

SUMIET & REMONUMENTATION APPROVED

NOV 2 6 1997

COMMISSION

26

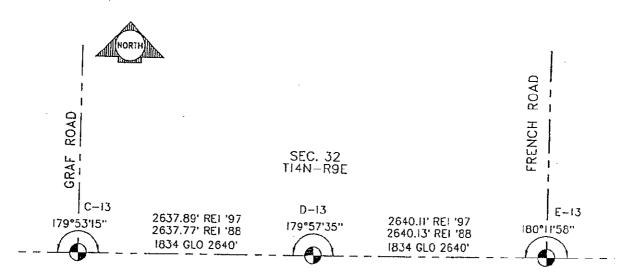

ELMWOOD ROAD

SEC. 5 TI3N-R9E