1997 REMONUMENTATION PROGRAM LAND CORNER RECORDATION CERTIFICATE

For corners in: COLUMBIA TV		irement of Act 74, Mich. P.A. 1	970		REGISTE	200	7 001 -	R KO	CEVED
TUSCOLA	Located In:	Corner Code #			으로 일요	3	7 /	2 P V	۳ 0 2
(County)					 	\$	73	35	
1. Public Land Survey	T_14N R_09E T R T R	F-13			\$ Q3	5	3: 02	NO.	RECORD
Property Controlling S in Section S Miscellaneous S	T R T R	Register of Deeds Stamp & File Number							
Property in Sec. S	TR				······································				
			1 <u>A</u>	8 (D	E F (ЭНІ	JK	LN
Lot No, Recorde Private Claims	d Plat		2	6	5	-4	а.	2	
			3 - 4	7	8	ģ	10	11	12
I, JONATHAN M. FIFLD in a field survey on JULY 23 19 97, do hereby certify that under requirements of P.A. 74, Michigan P.A. of 1970, the corner points mentioned in lines 1 and 2 above were in conformance with regulations and rules therefore as required in the current manual of survey instructions of the United States Department of the Interior, Bureau of Land Management or by a decree of a Court of Law and/or that the corner points mentioned in lines 3, 4 and 5 above were in conformance with the rules of the Michigan Board of Land Surveyors or by a Decree of a			5 - 6 7 -	18	17	16	15	14	13
			8	19	20	2]	22	23	24
Court of Law; established, re-est expressed below:			10	30	29	28	27	26	25
NOTE: Not more than 4 corner on this certificate.	s, all in the same town a	and range, may be recorded	12	3.1	32	33	34	35	36
A. Description of original monument and accessories and/or subsequent restoration: 1835 GLO; PARKE, D.S.; SET 1/4 SEC. POST; SUGAR 12 N54W 17LKS., SUGAR 7 N57 1/2E 24LKS.									
		•							
1997 ROWE; FIELD, PS#3727 BY SINGLE PROPOR	6; FND. NO EVIDENCE	plied in restoring or reestablishing c E OF MONUMENT AT CORNER NERS E-13 & G-13 T14N-R9E; DIVISION LINE		ESTA	BLISHI	ED CO	RNER	POSIT	ION
		·							
		RE-ESTABLISHMENT OF ORIG					.ON	;	ž,
F-13 REPLACED FND. ROI EAST, 29.41' FND. 1 N02°E, 53.00' P-K NAI	D W/ STD. REMON. MC /2" ROD W/ BROKEN (IL W/TAG #37276 IN E. IOTCH IN W. END 12" (DD W/CAP #37276 (S	tablished to perpetuate locating the DNUMENT STAMPED F 13 T14 CAP APPARENT F-1 T13N-1 FACE P.POLE (SET P-K NATOMP SET ROD W/CAP) SET ROD W/CAP)	N R9E R9E	E IN M	ON. BO	OX JOH M PROF	F M (CA NATHAN FIELD ESSION RVEYOR	AL)	
		,			7 =	\	No.	13	•


Surveyor's Mighigan License No.

37276

REVISED MAY 14, 1975 REVISED JAIN, 1893 ADAPTED FOR WORD PROCESSING MARCH, 1893

SUMVEY & REMONUMENTATION

NOV 2 6 1997

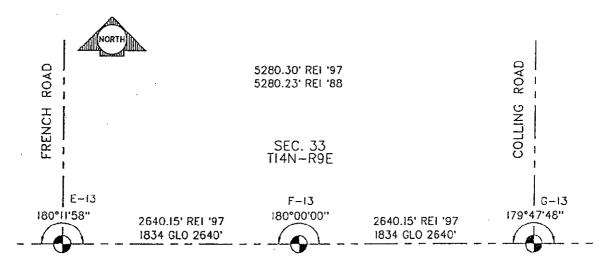

ELMWOOD ROAD

SEC. 4 TI3N-R9E