

**1997 REMONUMENTATION PROGRAM
LAND CORNER RECORDATION CERTIFICATE**
Filing Requirement of Act 74, Mich. P.A. 1970

TUSCOLA COUNTY
REGISTER OF DEEDS

RECEIVED FOR RECORD
LIBER NO. _____ PAGE NO. _____
FILE NO. # 58
COLUMBIA TOWNSHIP
97 OCT -7 PM 3:02

For corners in: COLUMBIA TWP.

<u>TUSCOLA</u> (County)	Located in:	Corner Code #
1. Public Land Survey	T <u>14N</u> R <u>09E</u>	<u>H-13</u>
	T _____ R _____	_____
	T _____ R _____	_____
	T _____ R _____	_____
2. Property Controlling in Section	S _____ T _____ R _____	_____
	S _____ T _____ R _____	_____
3. Miscellaneous Property in Sec.	S _____ T _____ R _____	_____
	S _____ T _____ R _____	_____
4. Lot No. _____	Recorded Plat _____	
5. Private Claims _____		

Register of Deeds Stamp & File Number

	A	B	C	D	E	F	G	H	I	J	K	L	M
1													
2	6		5		4		3		2		1		
3													
4	7		8		9		10		11		12		
5													
6	18		17		16		15		14		13		
7													
8	19		20		21		22		23		24		
9													
10	30		29		28		27		26		25		
11													
12	31		32		33		34		35		36		
13													

I, JONATHAN M. FIELD, in a field survey on JULY 23 1997, do hereby certify that under requirements of P.A. 74, Michigan P.A. of 1970, the corner points mentioned in lines 1 and 2 above were in conformance with regulations and rules therefore as required in the current manual of survey instructions of the United States Department of the Interior, Bureau of Land Management or by a decree of a Court of Law and/or that the corner points mentioned in lines 3, 4 and 5 above were in conformance with the rules of the Michigan Board of Land Surveyors or by a Decree of a Court of Law; established, re-established, monumented, re-monumented, recovered, found as expressed below:


NOTE: Not more than 4 corners, all in the same town and range, may be recorded on this certificate.

A. Description of original monument and accessories and/or subsequent restoration:
1835 GLO; PARKE, D.S.; SET 1/4 SEC. POST; BEECH 9 N82E 27LKS., SWAMP OAK 26 N39 1/2W 35LKS.

B. Description of corner evidence found and/or method applied in restoring or reestablishing corner:
1997 ROWE; FIELD, PS#37276; FND. 5/8" X 1 1/4" BAR; ALSO FND. 2 PLOW POINTS AND FRAGMENTS OF CLAY BELOW FND. BAR; PLACED PLOW POINTS ALONG SIDES OF MONUMENT.

ACCEPTED FND BAR AS BEST AVAILABLE EVIDENCE OF ORIGINAL CORNER POSITION

C. Description of monument for corner and accessories established to perpetuate locating the position of the corner:
H-13 REPLACED FND. BAR W/ STD. REMON. MONUMENT STAMPED H 13 T14N R9E IN MON. BOX EAST, 26.32' FND. 1 1/2" X 3" IRON APPARENT H-1 T13N-R9E
S63°W, 110.59' NAIL W/TAG #37276 IN NW FACE P.POLE (SET NAIL W/TAG)
S76°E, 187.71' NAIL W/TAG #37276 IN NE FACE P.POLE (SET NAIL W/TAG)
NORTH, 30.33' NAIL W/TAG #37276 IN E. FACE FENCE POST (SET NAIL W/TAG)
N42°E, 36.59' 1/2" ROD W/CAP #37276 (SET ROD W/CAP)
N43°W, 36.58' 1/2" ROD W/CAP #37276 (SET ROD W/CAP)

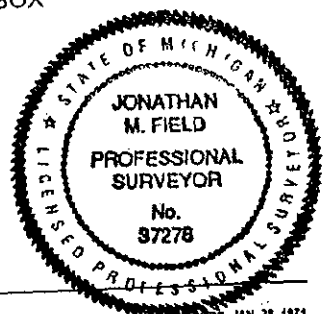

Signed by Jonathan M. Field
Surveyor's Michigan License No. 37276

Date 9-10-97

FORM APPROVED BY MICHIGAN STATE BOARD OF LAND SURVEYORS, JAN. 28, 1971
REVISED MAY 14, 1975
REVISED JAN. 1983
ADAPTED FOR WORD PROCESSING MARCH, 1983

APPROVED
9-8-97
TSO
JMG
RUB

SURVEY &
REMONUMENTATION
NOV 26 1997
COMMISSION

