

**1997 REMONUMENTATION PROGRAM
LAND CORNER RECORDATION CERTIFICATE**
Filing Requirement of Act 74, Mich. P.A. 1970

COPY

RECEIVED FOR RECORD
LIBER. NO. _____ PAGE NO. _____
FILE NO. # 59
COLUMBIA TOWNSHIP
97 OCT -7 PM 3:02
Jonathan M. Field
TUSCOLA COUNTY
REGISTER OF DEEDS

For corners in: COLUMBIA TWP.

<u>TUSCOLA</u> (County)	Located in:	Corner Code #
1. Public Land Survey	T <u>14N</u> R <u>09E</u>	<u>I-13</u>
	T _____ R _____	_____
	T _____ R _____	_____
	T _____ R _____	_____
2. Property Controlling in Section	S _____ T _____ R _____	_____
	S _____ T _____ R _____	_____
3. Miscellaneous Property in Sec.	S _____ T _____ R _____	_____
	S _____ T _____ R _____	_____

Register of Deeds Stamp & File Number

4. Lot No. _____, Recorded Plat _____
5. Private Claims _____

I, JONATHAN M. FIELD, in a field survey on JULY 23 19 97, do hereby certify that under requirements of P.A. 74, Michigan P.A. of 1970, the corner points mentioned in lines 1 and 2 above were in conformance with regulations and rules therefore as required in the current manual of survey instructions of the United States Department of the Interior, Bureau of Land Management or by a decree of a Court of Law and/or that the corner points mentioned in lines 3, 4 and 5 above were in conformance with the rules of the Michigan Board of Land Surveyors or by a Decree of a Court of Law; established, re-established, monumented, re-monumented, recovered, found as expressed below.

	A	B	C	D	E	F	G	H	I	J	K	L	M
1													
2	6	5	4	3	2	1							
3													
4	7	8	9	10	11	12							
5													
6	18	17	16	15	14	13							
7													
8	19	20	21	22	23	24							
9													
10	30	29	28	27	26	25							
11													
12	31	32	33	34	35	36							
13													

NOTE: Not more than 4 corners, all in the same town and range, may be recorded on this certificate.


A. Description of original monument and accessories and/or subsequent restoration:
1835 GLO; PARKE, D.S.; SET POST; BEECH 12 N59W 34LKS., ELM 30 N63E 40LKS.

B. Description of corner evidence found and/or method applied in restoring or reestablishing corner:
1997 ROWE; FIELD, PS#37276; FND. 1 3/4" SQUARE ROD, ALSO FND. 0.4'x1.2' WOOD POST SURROUNDED BY STONES BELOW FND. ROD

ACCEPTED FND ROD AS BEST AVAILABLE EVIDENCE OF ORIGINAL CORNER POSITION

C. Description of monument for corner and accessories established to perpetuate locating the position of the corner:
I-13 REPLACED FND. ROD W/ STD. REMON. MONUMENT STAMPED I 13 T14N R9E IN MON. BOX EAST, 29.92' 1/2" ROD W/CAP #11192 APPARENT I-1 T13N-R9E N54°E, 94.58' P-K NAIL W/TAG IN S. FACE P.POLE (FND. P-K NAIL) S61°E, 42.29' CHIS. + IN BOLT E. END 8' CMP S48°W, 64.41' NAIL W/TAG #11192 IN NE FACE P.POLE (FND NAIL W/TAG) N28°W, 45.12' P-K NAIL W/TAG #37276 IN NE FACE CUT-OFF T.POLE (SET P-K NAIL W/TAG)

Signed by *Jonathan M. Field* Date 9-10-97
Surveyor's Michigan License No. 37276

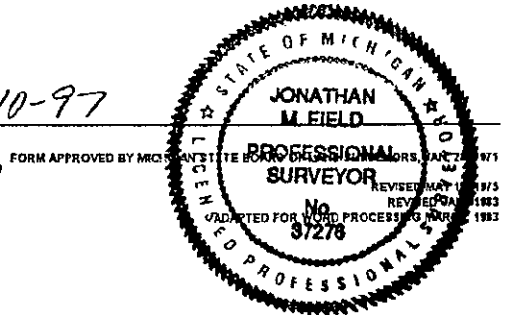

APPROVED
9-8-97
[Signatures]

SURVEY &
REMONUMENTATION
NOV 26 1997
COMMISSION

