

**1997 REMONUMENTATION PROGRAM
LAND CORNER RECORDATION CERTIFICATE**
Filing Requirement of Act 74, Mich. P.A. 1970

TUSCOLA COUNTY
REGISTERED OFFICES

RECEIVED FOR RECORD
LIBER NO. _____ PAGE NO. _____
FILE NO. #60
COLUMBIA TOWNSHIP
97 OCT -7 PM 3:02

For corners in: COLUMBIA TWP.

<u>TUSCOLA</u> (County)	Located In:	Corner Code #
1. Public Land Survey	T <u>14N</u> R <u>09E</u>	<u>J-13</u>
	T _____ R _____	_____
	T _____ R _____	_____
	T _____ R _____	_____
2. Property Controlling in Section	S _____ T _____ R _____	_____
	S _____ T _____ R _____	_____
3. Miscellaneous Property in Sec.	S _____ T _____ R _____	_____
	S _____ T _____ R _____	_____

Register of Deeds Stamp & File Number

4. Lot No. _____, Recorded Plat _____
5. Private Claims _____

I, JONATHAN M. FIELD, in a field survey on JULY 23 19 97, do hereby certify that under requirements of P.A. 74, Michigan P.A. of 1970, the corner points mentioned in lines 1 and 2 above were in conformance with regulations and rules therefore as required in the current manual of survey instructions of the United States Department of the Interior, Bureau of Land Management or by a decree of a Court of Law and/or that the corner points mentioned in lines 3, 4 and 5 above were in conformance with the rules of the Michigan Board of Land Surveyors or by a Decree of a Court of Law; established, re-established, monumented, re-monumented, recovered, found as expressed below:

NOTE: Not more than 4 corners, all in the same town and range, may be recorded on this certificate.


1	A	B	C	D	E	F	G	H	I	J	K	L	M
2		6	5	4	3	2	1						
3													
4		7	8	9	10	11	12						
5													
6		18	17	16	15	14	13						
7													
8		19	20	21	22	23	24						
9													
10		30	29	28	27	26	25						
11													
12		31	32	33	34	35	36						
13													

A. Description of original monument and accessories and/or subsequent restoration:
1835 GLO; PARKE, D.S.; SET 1/4 SEC. POST; HEMLOCK 9 N32E 6LKS., HEMLOCK 8 N81 1/2W 42LKS.

B. Description of corner evidence found and/or method applied in restoring or reestablishing corner:
1997 ROWE; FIELD, PS#37276; FND. R.R. SPIKE

ACCEPTED FND R.R. SPIKE AS BEST AVAILABLE EVIDENCE OF ORIGINAL CORNER POSITION

C. Description of monument for corner and accessories established to perpetuate locating the position of the corner:
J-13 REPLACED FND. RR SPIKE W/ STD. REMON. MONUMENT STAMPED J 13 T14N R9E IN MON. BOX
EAST, 20.22' FND. 1/2" ROD APPARENT J-1 T13N-R9E
N46°W, 28.96' 1/2" ROD W/CAP #37276 (SET ROD W/CAP)
N14°E, 55.84' NAIL W/TAG #11192 IN SE FACE P.POLE (FND NAIL W/TAG)
S40°E, 25.64' NAIL W/TAG #11192 IN N. FACE CUT-OFF T.POLE (FND NAIL W/TAG)
S40°E, 21.93' CHIS. NOTCH IN E. END 12" CMP
S20°W, 17.92' CHIS. NOTCH IN W. END 12" CMP

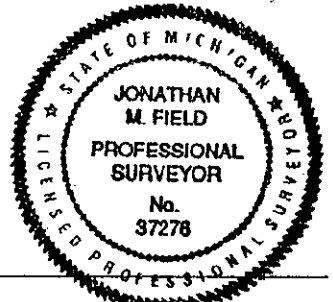

Signed by Jonathan M. Field Date 9-10-97
Surveyor's Michigan License No. 37276

FORM APPROVED BY MICHIGAN STATE BOARD OF LAND SURVEYORS, JAN. 28, 1971

REVISED MAY 14, 1975
REVISED JAN., 1983
ADAPTED FOR WORD PROCESSING MARCH, 1993

APPROVED
9-8-97
TOD
JAE
RLB

SURVEY &
REMONUMENTATION

NOV 26 1997

COMMISSION

