

MAR 02 1999

SECTION

1998 REMONUMENTATION PROGRAM  
LAND CORNER RECORDATION CERTIFICATE  
Filing Requirement of Act 74, Mich. P.A. 1970

RECEIVED FOR RECORD  
LIBER NO. \_\_\_\_\_ PAGE NO. \_\_\_\_\_  
FILE NO. #71 Columbia Twp.  
98 DEC 18 AM 10:09

For corners in COLUMBIA TOWNSHIP

TUSCOLA (County)	Located In:	Corner Code #
1. Public Land Survey	T 14N R 9E	M-5
	T _____ R _____	_____
	T _____ R _____	_____
	T _____ R _____	_____
2. Property Controlling in Section	S _____ T _____ R _____	_____
	S _____ T _____ R _____	_____
3. Miscellaneous Property in Sec.	S _____ T _____ R _____	_____
	S _____ T _____ R _____	_____

*Lionel Roy Emery*  
TUSCOLA COUNTY REGISTER OF DEEDS

Register of Deeds Stamp & File Number

4. Lot No. \_\_\_\_\_, Recorded Plat \_\_\_\_\_  
5. Private Claims \_\_\_\_\_

I, LIONEL ROY EMERY, in a field survey on OCT. 22, 19 98 do hereby state that under requirements of P.A. 74, Michigan P.A. of 1970, the corner points mentioned in lines 1 and 2 above were in conformance with regulations and rules therefore as required in the current manual of survey instructions of the United States Department of the Interior, Bureau of Land Management or by a decree of a Court of Law and/or that the corner points mentioned in lines 3, 4 and 5 above were in conformance with the rules of the Michigan Board of Land Surveyors or by a Decree of a Court of Law; established, re-established, monumented, recovered, found as expressed below:

NOTE: Not more than 2 corners, all in the same town and range, may be recorded on this certificate.

	A	B	C	D	E	F	G	H	I	J	K	L	M
1													
2	6		5			4		3		2		1	
3													
4	7		8			9		10		11		12	
5													
6	18		17			16		15		14		13	
7													
8	19		20			21		22		23		24	
9													
10	30		29			28		27		26		25	
11													
12	31		32			33		34		35		36	
13													

A. Description of original monument and accessories and/or subsequent restoration:

1835 GLO NOTES (PG. 136): HERVEY PARKE, DEP. SUR. SET POST CORNER SECS. 12 & 13; MAPLE 10 S38W 31; ELM 26 N24 1/2W 30- GLO NOTES (PAGES 356 AND 357); PARKE'S SURVEY OF LINE BETWEEN SECS. 7 & 18, T14N R10E (ELMWOOD TOWNSHIP) ADDS ACCESSORIES; W. ASH 8 N32E 6 1/2; HEMLOCK 9 S50E 25  
(NO DATE)-COUNTY SURVEYOR'S "MINUTES OF SURVEY" (PAGES 106 AND 107) BY: JOHN A. TESKEY, COUNTY SURVEYOR -SURVEY OF SECTION 18, T14N-R10E; CEDER AND CROCKERY PRE SET. (NO ACCESSORIES GIVEN)  
(NO DATE)-COUNTY SURVEYOR'S "MINUTES OF SURVEY" (PAGES 108 AND 109) BY: (NO SURVEYOR'S SIGNATURE) SURVEY OF SECTION 12, T14N-R9E; FOUND (NO OBJECT GIVEN); PRE SET BY B.T.-CEDER STAKE & CROCKERY  
SECTION 'A' CONTINUED ON THE REVERSE SIDE OF THIS CERTIFICATE.

B. Description of corner evidence found and/or method applied in restoring or reestablishing corner:

FOUND 5/8" RE-ROD IN MONUMENT BOX TOGETHER WITH 3 ACCESSORIES SHOWN ON SURVEYS IN SECTION A. ABOVE INDICATING FOUND RE-ROD TO BE IN SAME POSITION AS P.K. NAIL SET ON TOWNSHIP LINE BY DUNTON.

ACCEPTED FOUND RE-ROD AS A CAREFUL AND FAITHFUL PERPETUATION OF THE ORIGINAL GOVERNMENT CORNER.

C. Description of monument for corner and accessories established to perpetuate locating the position of the corner:


FITTED 5/8" RE-ROD IN MONUMENT BOX WITH STANDARD TUSCOLA COUNTY 2 IN. DIA. BRASS CAP STAMPED M5 T14N R9E. -PLACED CONCRETE IN MONUMENT BOX.

N55°E, 36.00 FT. SET CHISELED 'V' IN TOP NORTH END OF 60" CMP  
S60°E, 34.24 FT. SET CHISELED 'V' IN TOP SOUTH END OF 60" CMP  
S20°W, 87.78 FT. SET T.C. REMON TAG IN NORTHWEST FACE OF POWER POLE  
N40°W, 37.10 FT. SET T.C. REMON TAG OVER FOUND SPIKE IN NORTHEAST FACE OF 26" MAPLE  
N33°W, 22.19 FT. SET 1/2" RE-ROD IN GRAVEL SHOULDER  
N30°W, 52.56 FT. SET T.C. REMON TAG OVER FOUND SPIKE IN NORTHEAST FACE OF 26" MAPLE

NOTE: THIS CORNER IS COMMON WITH CORNER A 5 T14N R10E (ELMWOOD TOWNSHIP)

Signed by Lionel Roy Emery  
Surveyor's Michigan License No. 24593

Date DECEMBER 18, 1998

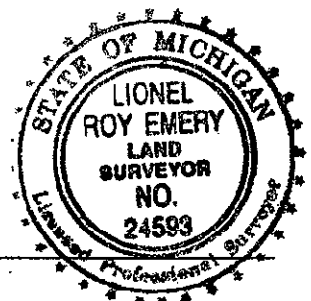

APPROVED  
12-9-98  
*[Signature]*

SURVEY &  
REMONUMENTATION

MAR 02 1999

SECTION

SECTION 'A' CONTINUED

- 1906 COUNTY SURVEYOR'S "MINUTES OF SURVEY" (PAGES 98 AND 99) BY: L. M. BRUMLEY, COUNTY SURVEYOR'S -SURVEY OF SECTION 13, T14N-R9E; CEDAR POST WITH LONG STONE AT EAST SIDE AT COR.; ELM 8 S34E 63 1/2; MAPLE 4 N41W 82
- 1977 RECORDED SURVEY (LIBER 478, PAGE 479 ) BY: EARL E. GRAVLIN, P.S. 23510; FOUND P.K. NAIL; N45°W 37.93' NAIL 24" MAPLE; N25°W 53.01' NAIL 24" MAPLE; S60°E 41.62' SIGN POST
- 1992 RECORDED SURVEY (LIBER 633, PAGE 505) BY: KENNETH D. DUNTON, P.S. #23503; SET P.K. NAIL ON TOWNSHIP LINE BY SINGLE PROPORTION METHOD; N45°W, 37.14' FND. SPIKE IN NE FACE OF 24" MAPLE; N25°W 52.60' FND. SPIKE IN NE FACE OF 24" MAPLE; S25°W, 87.75' P.K. IN PP; S60°E 46.2' ROAD SIGN POST

