

REMONUMENTATION

MAR 02 1999

1998 REMONUMENTATION PROGRAM
LAND CORNER RECORDATION CERTIFICATE
Filing Requirement of Act 74, Mich. P.A. 1970

RECEIVED FOR RECORD
LIBER NO. _____ PAGE NO. _____
FILE NO. #70 Columbia Twp
98 DEC 18 AM 10:08

SECTION
For corners in COLUMBIA TOWNSHIP

TUSCOLA
(County)

Located In: Corner Code #

- 1. Public Land Survey T 14N R 9E M-6
T R
T R
T R
- 2. Property Controlling in Section S T R
S T R
- 3. Miscellaneous Property in Sec. S T R
S T R

George M. Emery
TUSCOLA COUNTY
REGISTER OF DEEDS

Register of Deeds Stamp & File Number

- 4. Lot No. _____, Recorded Plat _____
- 5. Private Claims _____

I, LIONEL ROY EMERY, in a field survey on OCT. 22, 19 98 do hereby state that under requirements of P.A. 74, Michigan P.A. of 1970, the corner points mentioned in lines 1 and 2 above were in conformance with regulations and rules therefore as required in the current manual of survey instructions of the United States Department of the Interior, Bureau of Land Management or by a decree of a Court of Law and/or that the corner points mentioned in lines 3, 4 and 5 above were in conformance with the rules of the Michigan Board of Land Surveyors or by a Decree of a Court of Law; established, re-established, monumented, recovered, found as expressed below:

NOTE: Not more than 2 corners, all in the same town and range, may be recorded on this certificate.

A	B	C	D	E	F	G	H	I	J	K	L	M
1												
2	6		5		4		3		2		1	
3												
4	7		8		9		10		11		12	
5												
6	18		17		16		15		14		13	
7												
8	19		20		21		22		23		24	
9												
10	30		29		28		27		26		25	
11												
12	31		32		33		34		35		36	
13												

A. Description of original monument and accessories and/or subsequent restoration:

1835 GLO NOTES (PG. 135); HERVEY PARKE, DEP. SUR. SET QR. SEC. POST; B. ASH 10 S9W 9; B. ASH 16 N29W 38 (NO DATE)-COUNTY SURVEYOR'S "MINUTES OF SURVEY" (PAGES 106 AND 107) BY: JOHN A. TESKEY, COUNTY SURVEYOR SURVEY OF SECTION 18, T14N-R10E; CEDER AND CROCKERY PRE SET. (NO ACCESSORIES GIVEN)
1906 COUNTY SURVEYOR'S "MINUTES OF SURVEY" (PAGES 98 AND 99) BY: L. M. BRUMLEY, COUNTY SURVEYOR'S -SURVEY OF SECTION 13, T14N-R9E; CEDAR POST AND STONES AT COR.; MAPLE 5 S9 1/4E 2.04 1/2
1972 RECORDED SURVEY (LIBER 2 OF SURVEYS, PAGES 130 AND 139- DUPLICATE RECORDING) BY: ROBERT G. KAY, P.S. 14096; (NO OBJECT STATED); S70°W 40.10' TO PP; WEST 10.05' TO EDGE BIT; N20°E 148.45' TO 36" CMP
SECTION 'A' CONTINUED ON THE REVERSE SIDE OF THIS CERTIFICATE.

B. Description of corner evidence found and/or method applied in restoring or reestablishing corner:

FOUND MONUMENT BOX NOTHING INSIDE.

ACCEPTED FOUND MONUMENT BOX AS A CAREFUL AND FAITHFUL PERPETUATION OF THE ORIGINAL GOVERNMENT CORNER.


C. Description of monument for corner and accessories established to perpetuate locating the position of the corner:

DROVE 5/8" RE-ROD IN CENTER OF FOUND MONUMENT BOX, ATTACHED STANDARD TUSCOLA COUNTY 2 IN. DIA. BRASS CAP STAMPED M6 T14N R9E. -PLACED CONCRETE IN MONUMENT BOX.
N10°E, 128.83 FT. SET CHISELED '+' IN SOUTH END (TOP) OF 42" CMP
N32°E, 25.03 FT. SET 1/2" REROD IN GRAVEL SHOULDER
S35°E, 32.70 FT. SET 5/8" RE-ROD IN @ TOP OF DITCH SLOPE
S50°W, 40.36 FT. SET T.C. REMON TAG IN SOUTHEAST FACE OF POWER POLE
WEST, 28.12 FT. SET T.C. REMON TAG IN NORTH FACE OF POST

NOTE: THIS CORNER IS COMMON WITH CORNER A 6 T14N R10E (ELMWOOD TOWNSHIP)

Signed by Lionel Roy Emery
Surveyor's Michigan License No. 24593

Date DECEMBER 18, 1998

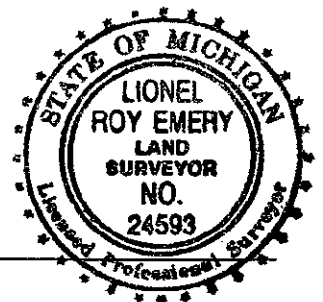

APPROVED
12-9-98
J.M.T.
R.R.B.

SECTION 'A' CONTINUED

1977 RECORDED SURVEY (LIBER 478, PAGE 479) BY: EARL E. GRAVLIN, P.S. 23510; FOUND P.K. NAIL; WEST 28.22'
COR. POST; S50°W 40.00' P.P.; EAST 10.20' EAST EDGE BLACKTOP

SURVEY &
REMONUMENTATION

MAR 02 1999

SECTION

