

SURVEY & REMONUMENTATION

MAR 02 1999

1998 REMONUMENTATION PROGRAM
LAND CORNER RECORDATION CERTIFICATE
 Filing Requirement of Act 74, Mich. P.A. 1970

RECEIVED FOR RECORD
 LIBER NO. _____ PAGE NO. _____
 FILE NO. # 69 Columbia Twp

98 DEC 18 AM 10:08

SECTION
 For corners in COLUMBIA TOWNSHIP

TUSCOLA (County)	Located in:	Corner Code #
1. Public Land Survey	T <u>14</u> N R <u>9</u> E	<u>M-7</u>
	T _____ R _____	_____
	T _____ R _____	_____
	T _____ R _____	_____
2. Property Controlling in Section	S _____ T _____ R _____	_____
	S _____ T _____ R _____	_____
3. Miscellaneous Property in Sec.	S _____ T _____ R _____	_____
	S _____ T _____ R _____	_____

Gregory M. Emery
 TUSCOLA COUNTY
 REGISTER OF DEEDS

Register of Deeds Stamp & File Number

4. Lot No. _____, Recorded Plat _____
 5. Private Claims _____

I, LIONEL ROY EMERY, in a field survey on OCT. 16, 19 98 do hereby state that under requirements of P.A. 74, Michigan P.A. of 1970, the corner points mentioned in lines 1 and 2 above were in conformance with regulations and rules therefore as required in the current manual of survey instructions of the United States Department of the Interior, Bureau of Land Management or by a decree of a Court of Law and/or that the corner points mentioned in lines 3, 4 and 5 above were in conformance with the rules of the Michigan Board of Land Surveyors or by a Decree of a Court of Law; established, re-established, monumented, recovered, found as expressed below:

	A	B	C	D	E	F	G	H	I	J	K	L	M
1													
2	6		5		4		3		2		1		
3													
4	7		8		9		10		11		12		
5													
6	18		17		16		15		14		13		
7													
8	19		20		21		22		23		24		
9													
10	30		29		28		27		26		25		
11													
12	31		32		33		34		35		36		
13													

NOTE: Not more than 2 corners, all in the same town and range, may be recorded on this certificate.

A. Description of original monument and accessories and/or subsequent restoration:
 1835 GLO NOTES (PG. 135): HERVEY PARKE, DEP. SUR. SET POST CORNER SECS 13 & 24; HEMLOCK 14 S6W 9; HEMLOCK HEMLOCK 20 N26 1/2W 31- GLO NOTES (PAGE 355); PARKE'S SURVEY OF LINE BETWEEN SECS. 18 & 19, T14N R10E (ELMWOOD TOWNSHIP) ADDS ACCESSORIES; CEDAR 20 S61E 35 1/2; W. ASH 28 N2 1/2E 29 (NO DATE)-COUNTY SURVEYOR'S RECORD (PAGES 106 AND 107) BY: JOHN A. TESKEY, COUNTY SURVEYOR -SURVEY OF SECTION 18, T14N-R10E; CEDER AND CROCKERY PRE SET. (NO ACCESSORIES GIVEN)
 1895 COUNTY SURVEYOR'S RECORD (PAGES 260 AND 261) BY: EDWARD L. TESKEY, COUNTY SURVEYOR'S SURVEY OF SECTION 24, T14N-R9E; STAKE PREVIOUSLY ESTABLISHED; ELM 5" S29°E 1.29 1/2; APPLE 4" N26 1/2°W 1.46 SECTION 'A' CONTINUED ON THE REVERSE SIDE OF THIS CERTIFICATE.

B. Description of corner evidence found and/or method applied in restoring or reestablishing corner:
 FOUND 1 1/4" DIA. PIPE IN MONUMENT BOX. FOUND 4 ACCESSORIES WHICH WITNESS THE POSITION OF FOUND PIPE AS INDICATED ON DOCUMENTS CITED IN SECTION A. ABOVE.

ACCEPTED FOUND PIPE AS A CAREFUL AND FAITHFUL PERPETUATION OF THE ORIGINAL GOVERNMENT CORNER.

C. Description of monument for corner and accessories established to perpetuate locating the position of the corner:
 DROVE 5/8" RE-ROD INSIDE FOUND PIPE, ATTACHED STANDARD TUSCOLA COUNTY 2 IN. DIA. BRASS CAP STAMPED M7 T14N R9E. -PLACED CONCRETE IN MONUMENT BOX.


- N19°E, 40.27 FT. SET 1/2" REROD IN GRAVEL SHOULDER
- N50°E, 57.81 FT. SET T.C. REMON TAG IN NORTHWEST FACE OF POLE (MEAS. 57.4' TO FACE)
- S30°E, 35.48 FT. SET 5/8" RE-ROD IN GRAVEL SHOULDER
- S45°W, 42.72 FT. SET T.C. REMON TAG IN SOUTHEAST FACE OF GUY POLE (MEAS. 42.4' TO NORTHEAST FACE)
- S60°W, 54.64 FT. SET T.C. REMON TAG IN NORTHWEST FACE OF POWER POLE (MEAS. 53.9' TO NORTHEAST FACE)
- N55°W, 62.11 FT. SET T.C. REMON TAG IN NORTHEAST FACE OF POWER POLE (MEAS. 61.75' TO SOUTHEAST FACE)

NOTE: THIS CORNER IS COMMON WITH CORNER A 7 T14N R10E (ELMWOOD TOWNSHIP)

Signed by Lionel Roy Emery
 Surveyor's Michigan License No. 24593

Date DECEMBER 18, 1998

APPROVED
12-9-98
[Signature]
[Signature]

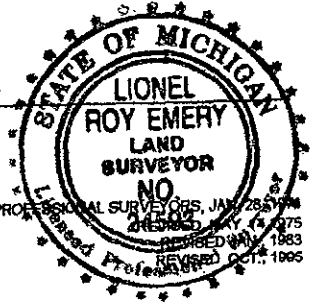

SECTION 'A' CONTINUED

1906 COUNTY SURVEYOR'S "MINUTES OF SURVEY" (PAGES 98 AND 99) BY: L. M. BRUMLEY, COUNTY SURVEYOR'S SURVEY OF SEC 13, T14N-R9E; REFERS TO SECTION 24,-13-9 (?)
1972 RECORDED SURVEY (LIBER 2 OF SURVEYS, PAGES 130 AND 139-- DUPLICATE RECORDING) BY: ROBERT G. KAY, P.S. 14096; S45°W 42.35' PP ANCHOR; N45°W 45.4' PP; S25°W 84.75' 10" BUTTERNUT
1976 RECORDED SURVEY (LIBER 459, PAGE 598) BY: JAMES A. BECK, P.S. 21559; P.K. NAIL OVER MAGNETIC PULL; S45°W 42.3' GUY POLE; N45°W 45.34' PP; N45°E 57.55' GUY POLE; S50°W 53.85' PP

SURVEY &
REMONUMENTATION

MAR 02 1999

SECTION

