

SURVEY & REMONUMENTATION

MAR 02 1999

**1998 REMONUMENTATION PROGRAM
LAND CORNER RECORDATION CERTIFICATE
Filing Requirement of Act 74, Mich. P.A. 1970**

SECTION

For corners in ELMWOOD TOWNSHIP

TUSCOLA

(County)

Located In:

Corner Code #

1. Public Land Survey

T 14N R 10E A-2

T _____ R _____

T _____ R _____

T _____ R _____

2. Property Controlling in Section

S _____ T _____ R _____

S _____ T _____ R _____

3. Miscellaneous Property in Sec.

S _____ T _____ R _____

S _____ T _____ R _____

4. Lot No. _____, Recorded Plat _____

5. Private Claims _____

I, LIONEL ROY EMERY, in a field survey on OCT. 22, 19 98 do hereby state that under requirements of P.A. 74, Michigan P.A. of 1970, the corner points mentioned in lines 1 and 2 above were in conformance with regulations and rules therefore as required in the current manual of survey instructions of the United States Department of the Interior, Bureau of Land Management or by a decree of a Court of Law and/or that the corner points mentioned in lines 3, 4 and 5 above were in conformance with the rules of the Michigan Board of Land Surveyors or by a Decree of a Court of Law; established, re-established, monumented, recovered, found as expressed below:

NOTE: Not more than 2 corners, all in the same town and range, may be recorded on this certificate.

A. Description of original monument and accessories and/or subsequent restoration:

1835 GLO NOTES (PG. 329); HERVEY PARKE, DEP. SUR. SET QR. SEC. POST ; ELM 15 S12W 79; MAPLE 22 N28 1/2W 46

B. Description of corner evidence found and/or method applied in restoring or reestablishing corner:

FOUND NOTHING--CORNER CONSIDERED LOST.
REESTABLISHED CORNER POSITION BY SINGLE PROPORTION METHOD. LATITUDE OF PROPORTIONED POSITION FALLS IN LINE WITH OCCUPATION TO WEST (SHALLOW DITCH) AND IS 6.3± FEET NORTH OF CENTERLINE OF 10 FT. DEEP DRAIN TO EAST.

ACCEPTED POSITION AS A CAREFUL AND FAITHFUL REESTABLISHMENT OF THE ORIGINAL GOVERNMENT CORNER.

C. Description of monument for corner and accessories established to perpetuate locating the position of the corner:


SET STANDARD TUSCOLA COUNTY CONCRETE MONUMENT WITH 2 IN. DIA. BRASS CAP STAMPED M 2 T14N R9E
-PLACED MONUMENT BOX OVER MONUMENT

N30°E, 17.22 FT. SET 1/2" RE-ROD IN GRAVEL SHOULDER
S15°E, 41.02 FT. SET 5/8" RE-ROD IN GRAVEL SHOULDER
S22°W, 100.52 FT. SET T.C. REMON TAG IN NORTHWEST FACE OF POWER POLE
N25°W, 104.68 FT. SET T.C. REMON TAG IN SOUTHWEST FACE OF POWER POLE
WEST, 5.3± FT. CENTERLINE OF BITUMINOUS PAVEMENT

NOTE: THIS CORNER IS COMMON WITH CORNER M 2 T14N R9E (COLUMBIA TOWNSHIP)

Signed by Lionel Roy Emery
Surveyor's Michigan License No. 24593

Date DECEMBER 13, 1998

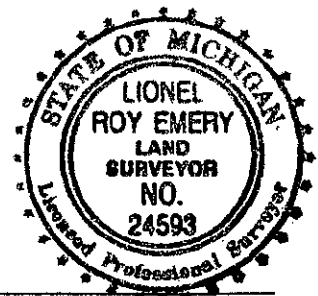

RECEIVED FOR RECORD
LIBER NO. _____ PAGE NO. _____
FILE NO. #128 Elmwood Twp.

98 DEC 18 AM 10:07

Lionel Roy Emery
TUSCOLA COUNTY
REGISTER OF DEEDS

Register of Deeds Stamp & File Number

	A	B	C	D	E	F	G	H	I	J	K	L	M
1													
2	6		5		4		3		2		1		
3													
4	7		8		9		10		11		12		
5													
6	10		17		16		15		14		13		
7													
8	19		20		21		22		23		24		
9													
10	30		29		28		27		26		25		
11													
12	31		32		33		34		35		36		
13													

APPROVED 1500
12-9-98

SURVEY &
REMONUMENTATION

MAR 02 1999

SECTION

