

MAR 02 1999

RECEIVED FOR RECORD

LIBER NO. _____ PAGE NO. _____

FILE NO. #59 Elmwood Twp.

SECTION

1998 REMONUMENTATION PROGRAM
LAND CORNER RECORDATION CERTIFICATE
Filing Requirement of Act 74, Mich. P.A. 1970

98 DEC 18 AM 10:06

For corners in ELMWOOD TOWNSHIP

Lionel Roy Emery
TUSCOLA COUNTY
REGISTER OF DEEDS

TUSCOLA (County)	Located In:	Corner Code #
1. Public Land Survey	T 14N R 10E	A-11
	T _____ R _____	_____
	T _____ R _____	_____
	T _____ R _____	_____
2. Property Controlling in Section	S _____ T _____ R _____	_____
	S _____ T _____ R _____	_____
3. Miscellaneous Property in Sec.	S _____ T _____ R _____	_____
	S _____ T _____ R _____	_____

Register of Deeds Stamp & File Number

4. Lot No. _____, Recorded Plat _____
5. Private Claims _____

I, LIONEL ROY EMERY, in a field survey on OCT. 16, 19 98 do hereby state that under requirements of P.A. 74, Michigan P.A. of 1970, the corner points mentioned in lines 1 and 2 above were in conformance with regulations and rules therefore as required in the current manual of survey instructions of the United States Department of the Interior, Bureau of Land Management or by a decree of a Court of Law and /or that the corner points mentioned in lines 3, 4 and 5 above were in conformance with the rules of the Michigan Board of Land Surveyors or by a Decree of a Court of Law, established, re-established, monumented, recovered, found as expressed below:

NOTE: Not more than 2 corners, all in the same town and range, may be recorded on this certificate.

	A	B	C	D	E	F	G	H	I	J	K	L	M
1													
2	6		5			4		3		2		1	
3													
4	7		8			9		10		11		12	
5													
6	10		17		16		15		14		13		
7													
8	19		20		21		22		23		24		
9													
10	30		29		28		27		26		25		
11													
12	31		32		33		34		35		36		
13													

A. Description of original monument and accessories and/or subsequent restoration:

- 1835 GLO NOTES PG. 326: HERVEY PARKE, DEP. SUR. SET POST CORNER SECS 25 & 36; HEMLOCK 9 N12W 13; HEMLOCK 26 S12 1/2W 27; GLO NOTES (PAGE 352) OF PARKE'S SURVEY OF LINE BETWEEN SECS. 30 & 31, T14N R10E (ELMWOOD TOWNSHIP) ADDS ACCESSORIES; HEMLOCK 18 S15E 30; CEDAR 14 N24E 29
- 1886, JUNE 22-COUNTY SURVEYOR'S RECORD (PAGES 58 AND 59) BY: JOHN A. TESKEY, COUNTY SURVEYOR; SURVEY OF SECTION 30, T14N-R10E; REFERS TO SURVEYOR'S RECORD (PAGE 57) SOUTHEAST CORNER OF SEC. 25, COLUMBIA TOWNSHIP (T14N-R9E)
- 1886, JUNE 26-COUNTY SURVEYOR'S RECORD (PAGES 60 AND 61) BY: JOHN A. TESKEY, COUNTY SURVEYOR; REFERS TO NE. CORNER OF SEC. 36, OF COLUMBIA TWP. (T14N-R9E), PAGE 55 OF COUNTY SURVEYOR'S RECORD. SECTION 'A' CONTINUED ON THE REVERSE SIDE OF THIS CERTIFICATE.

B. Description of corner evidence found and/or method applied in restoring or reestablishing corner:

FOUND BOATSPIKE IN MONUMENT BOX
RECOVERED 3 ACCESSORIES AS SHOWN ON LAND CORNER RECORDATION CERTIFICATE AND SURVEYS BY DUNTON, EMERY AND SZYSZKOSKI INDICATING BOATSPIKE TO BE IN THE SAME POSITION AS NOTED ON THOSE DOCUMENTS.

ACCEPTED BOATSPIKE AS A CAREFUL AND FAITHFUL PERPETUATION OF ORIGINAL GOVERNMENT CORNER.

C. Description of monument for corner and accessories established to perpetuate locating the position of the corner:


SET STANDARD TUSCOLA COUNTY 2 IN. DIA. BRASS CAP STAMPED M11 T14N R9E.
PLACED CONCRETE IN MONUMENT BOX.

- N22°E, 48.92 FT. SET 1/2" REROD IN GRAVEL SHOULDER
- S40°E, 32.64 FT. SET CHISELED '+' ATOP C.L. @ EAST END OF 48" CMP
- S45°W, 44.32 FT. SET T.C. REMON TAG IN NW. FACE MULTI-TRUNK MAPLE
- S50°W, 58.43 FT. FOUND NE. CORNER OF HOUSE #4497
- N40°W, 70.88 FT. FOUND SE. CORNER OF HOUSE #1997 @ BLOCK FOUNDATION

NOTE: THIS CORNER IS COMMON WITH CORNER M 11 T14N R9E (COLUMBIA TOWNSHIP)

Signed by Lionel Roy Emery
Surveyor's Michigan License No. 24593

Date DECEMBER 18, 1998

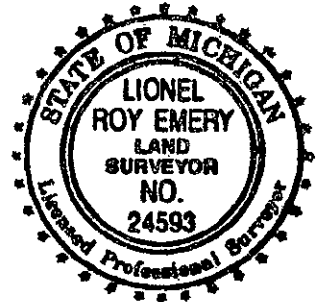

APPROVED
12-9-98
[Signature]

SURVEY &
REMONUMENTATION

MAR 02 1999

SECTION

SECTION 'A' CONTINUED

- 1886, JULY 1--COUNTY SURVEYOR'S RECORD (PAGES 56 AND 57) BY: JOHN A. TESKEY, COUNTY SURVEYOR; REFERS TO NE. COR. OF SECTION 36, (T14N-R9E); -PAGE 55 OF COUNTY SURVEYOR'S RECORD.
- 1886, JULY 3--COUNTY SURVEYOR'S RECORD (PAGES 54 AND 55) BY: JOHN A. TESKEY, COUNTY SURVEYOR; CROCKERY AT STAKE; HEMLOCK 18 N24E 29
- 1977 LAND CORNER RECORDATION CERTIFICATE (FILING NO. 20, COLUMBIA TOWNSHIP) BY: KENNETH D. DUNTON, P.S. 23503; FOUND AXLE SHAFT-RAISED WITH POINTED IRON; S50°W, 61.60' RLS TAG 11192 TAG IN PP; N40°W, 70.85' SE COR DWELLING #1997; S45°W 58.38' NE COR OF DWELLING #4497; S40°W, 44.6' CNTR. MAPLE CLUMP
- 1981 RECORDED SURVEY (LIBER 515, PAGE 1104) BY: LIONEL ROY EMERY; MARKER AND ACCESSORIES SAME AS 1977 L.C.R.C. ABOVE
- 1989 RECORDED SURVEY (LIBER 593, PAGES 800, 801 AND 802) BY: STEPHAN J. SZYSZKOSKI, P.S. 33986; FOUND 3/8" PIN WITH ROUND HEAD IN MONUMENT BOX; N45°E 54.9' BASE OF STREET SIGN; N40°W, 70.85' SOUTHEAST CORNER DWELLING #1997; S45°W, 58.38' NE CORNER DWELLING #4497; S40°W, 44.6' CENTER MAPLE CLUMP

